

RECORD OF LAND CORNER MONUMENTATION

CORNER #3 CYCLONE QUARTZ CLAIM, MINERAL SURVEY 366,
IDENTICAL WITH CORNER #5 OHIO QUARTZ CLAIM, MINERAL SURVEY 381,
SITUATED IN SECTION 32, T. 8 S., R. 37 E., W.M.
PAGE 1 OF 2


ORIGINALLY ESTABLISHED BY: Charles M. Foster, U.S. Deputy Mineral Surveyor

MINERAL SURVEY NUMBER: 366

COMPLETION DATE: August 18, 1899

SUBSEQUENT SURVEYS:

- ▶ Mineral Survey 381 by Charles M. Foster, U.S. Deputy Mineral Surveyor, completed December 28, 1899
- ▶ G.L.O. Retracement by Lincoln E. Wilkes, U.S. Cadastral Engineer, under Group No. 107, Approved May 26, 1927
- ▶ Corner search notes by John R. Mitchell, an unlicensed Survey Technician, as documented on U.S. Forest Service corner cards dated 9/11/1969
- ▶ Unrecorded remonumentation by John R. Mitchell, an unlicensed Survey Technician, as documented on two U.S. Forest Service corner card dated 6/30/1981

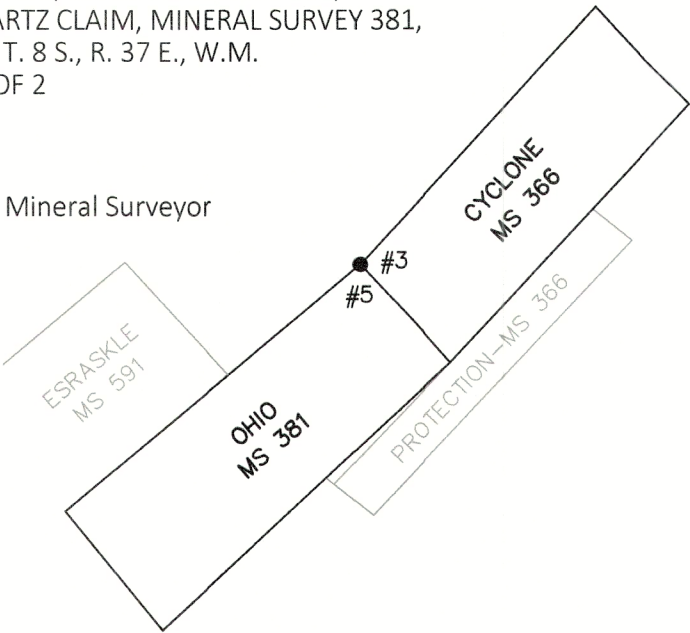

MS 366 DESCRIPTION: To Cor. No. 3. Identical with old corner a Post 4 ½ feet long 4 inches square set 18 inches in the ground with mound of earth & stones scribed Cor. No. 3 - 366
A Tamarac 18" dia. bears N3°W 12 ft.
A Tamarac 18" dia. bears S21°W 14 ft. each blazed and scribed Cor No. 3 - 366 BT

MS 381 DESCRIPTION: To cor. No. 5. Identical with cor. no. 3 of Cyclone Lode Survey No 366, and N.E. cor. of location of Ohio Lode. A fir post 4 ft. long, 4 ins. square, set 18 ins in the ground, scribed cor. 5 - 381 whence
A pine 16 ins. Dia. bears S72°W 7.3 ft Dist blazed and scribed cor. 5 - 381 - B.T.
A fir 10 ins. Dia. bears S13°20'E 28.1 ft. Dist. blazed and scribed cor. 5 - 381 - B.T.

G.L.O.DESCRPTION: Cor. No. 5, common with cor. No. 3, Cyclone Claim, Sur. No. 366, as described

MITCHELL'S 1969 DESCRIPTIONS:

DESCRIBE CORNER MONUMENT FOUND: mound of stone

DESCRIBE BEARING TREES OR OTHER OFFICIAL ACCESSORIES FOUND

26" W.L. brs N.18°W. 12 ft.
22" W.L. brs S.21°W. 14 ft.

The surveyor calls for a bearing of N43°30'E. from this corner to Cor. #4 with a variation of 20°35' and it actually worked. I find that either my compass is affected by local attraction on some of these runs in the Bourne area or something was wrong in the first place, as much as 3° or 4°

30" P.P. (Green) brs. S.72°W. 7.3'
30" W.F. stump brs. S.13°E. 28'

This corner identical with COR. #3 of M.S. 366 and this surveyor marked #3 on the pine.

MITCHELL'S 1981 DESCRIPTION:

DESCRIBE CORNER MONUMENT FOUND: Rotted post in md of stone

DESCRIBE BEARING TREES OR OTHER OFFICIAL ACCESSORIES FOUND

18" W.L. brs S21°W 14' w/ scribing in opened blaze
18" dead W.L. brs N3°W 12' w/ scribing in opened blaze


MONUMENT: DESCRIBE NEW MONUMENT SET, OR WORK DONE TO PRESERVE EXISTING MONUMENT

2 ½" BC on 1" X 32" gal. pipe set 27" deep in original hole & md marked CYC C3 MS 366 JRM 1981 & angle

FILED September 24, 2025
BAKER COUNTY SURVEYOR
SURVEY NO. 8-37-226

RECORD OF LAND CORNER MONUMENTATION

CORNER #3 CYCLONE QUARTZ CLAIM, MINERAL SURVEY 366,
IDENTICAL WITH CORNER #5 OHIO QUARTZ CLAIM, MINERAL SURVEY 381,
SITUATED IN SECTION 32, T. 8 S., R. 37 E., W.M.
PAGE 2 OF 2

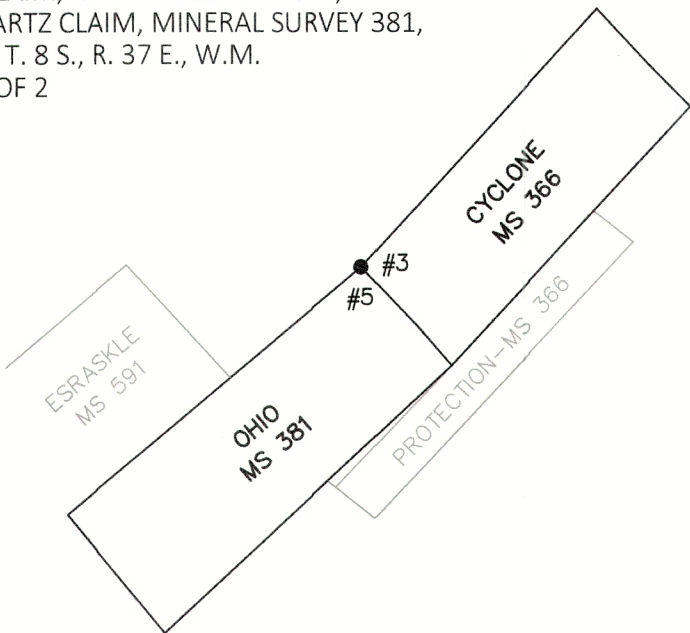

MITCHELL'S 1981 DESCRIPTION (CONTINUED):

ACCESSORIES: DESCRIBE NEW BT's WITNESS OBJECTS ETC. ESTABLISHED, OR WORK DONE TO PRESERVE EXISTING EVIDENCE: 10" WF brs. S19°W 9' marked CYC 3 MS 366 B.T.

EVIDENCE FOUND: Found Mitchell's unrecorded monument, which is a 1 1/2" galvanized iron pipe with a 2 1/2" brass cap, marked as shown, projecting 2" above ground in a 2 ft. diameter mound of stone, with a steel fence post with USFS 54-9 sign attached set alongside. From which,


- ▶ A white fir, 16" dbh, bears S.32°W, 9.0 ft., with fully-healed single blaze (Mitchell BT)
- ▶ A western larch snag, 19" dbh, bears S.34°W, 14.8 ft., with fragmentary scribing visible in an opened blaze. Distance measured to face of blaze (MS 366 BT)
- ▶ A ponderosa pine, 27" dbh, bears N.70°W., 7.45 ft., with scribing COR No 3 legible among other fragmentary scribe marks in an opened blaze. Distance measured to face of blaze (MS 381 BT)
- ▶ A dead and down western larch (wind-thrown), 15" diameter, bears N.12°W., 14 ft.+/-, with visible scribing on an opened blaze (MS 366 BT)

DESCRIPTION OF MONUMENTS AND ACCESSORIES SET AND METHODS USED:

I accept Mitchell's brass cap monument as a faithful and accurate perpetuation of the original corner, being harmoniously related to other accepted found monuments of the Cyclone Quartz Claim.

Painted a 6 inch red band around each bearing tree, and also painted the blazes red, and attached new USFS 54-3 and 54-9 signs. Distance to Mitchell's BT measured with a steel tape to a Mag Spike driven in the side-center-right at the root crown of each tree, with an attached 1 1/2" aluminum washer stamped PLS 69454. Used RTK GPS to measure bearings. Bearings are geodetic, based on GPS observation taken at the corner. Set an aluminum guard post N.43°E., 5 ft. with USFS 54-2 attached, and another post S.51°W., with USFS 54-2 and 54-9 signs attached. See associated Map of Survey dated August 20, 2025 for survey-related information.

CORNER MONUMENT MARKED:

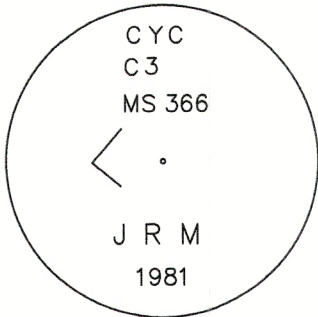

RESTORATION BY, STAMP AND DATE:

Work performed August 23, 2024
Survey completed August 20, 2025

Jason L. Hatfield, PLS

USDA FOREST SERVICE
NORTHEAST OREGON LAND ZONE
1550 Dewey Avenue, Suite A
Baker City, OR 97814
(541) 523-1283

FILED September 24, 2025
BAKER COUNTY SURVEYOR
SURVEY NO. 8-37-226

REGISTERED
PROFESSIONAL
LAND SURVEYOR


OREGON
NOVEMBER 30, 2007
JASON L. HATFIELD
#69454
EXPIRES: 6/30/2027