


RECORD OF LAND CORNER MONUMENTATION

CORNER #4 CYCLONE QUARTZ CLAIM, MINERAL SURVEY 366,
SITUATED IN SECTION 32, T. 8 S., R. 37 E., W.M.
PAGE 1 OF 2

ORIGINALLY ESTABLISHED BY: Charles M. Foster, U.S. Deputy Mineral Surveyor
MINERAL SURVEY NUMBER: 366
COMPLETION DATE: August 18, 1899

SUBSEQUENT SURVEYS:

- G.L.O. Retracement by Lincoln E. Wilkes, U.S. Cadastral Engineer, under Group No. 107, Approved May 26, 1927
- Corner search notes by John R. Mitchell, an unlicensed Survey Technician, as documented on U.S. Forest Service corner card dated 8/27/1969
- Unrecorded remonumentation by John R. Mitchell, an unlicensed Survey Technician, as documented on U.S. Forest Service corner card dated 6/29/1981

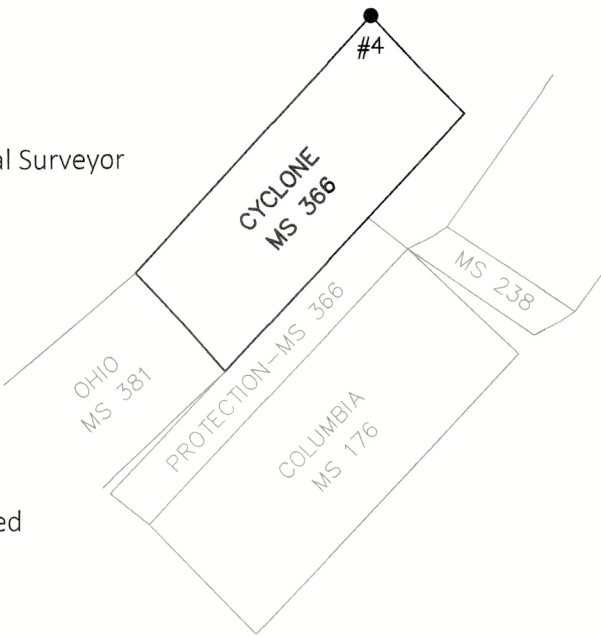

ORIGINAL DESCRIPTION: To Cor. No. 4. A Post 4 1/2 feet long 4 inches square set 18 inches in the ground with mound of earth & stones scribed Cor. No. 4 - 366
A Tamarac 24" dia bears N85°W 58 ft. blazed and scribed Cor No. 4 - 366 BT

G.L.O. DESCRIPTION: Cor. No. 4, as described

MITCHELL'S 1969 DESCRIPTION:
DESCRIBE CORNER MONUMENT FOUND
mound of stone

DESCRIBE BEARING TREES OR OTHER OFFICIAL ACCESSORIES FOUND
32" Green Larch brs. West 58'
Distances appear to be O.K. on B.T.'s but bearings given by the surveyor are so far off that he undoubtedly quoted from memory. Also he says the bearing from Cor. #4 to P.O.B. is N.43°30'E. But it is more like N.50°E.

MITCHELL'S 1981 DESCRIPTION:
DESCRIBE CORNER MONUMENT FOUND
Rotted post in md of stone

DESCRIBE BEARING TREES OR OTHER OFFICIAL ACCESSORIES FOUND
30" gr W.L. brs N85°W w/ scribing opened blaze


MONUMENT: DESCRIBE NEW MONUMENT SET, OR WORK DONE TO PRESERVE EXISTING MONUMENT
2 1/2" BC on 1" X 32" gal. pipe set 26" deep in original hole & md marked CLC 4 MS 366 JRM 1981 & angle

ACCESSORIES: DESCRIBE NEW BT'S WITNESS OBJECTS ETC. ESTABLISHED, OR WORK DONE TO PRESERVE EXISTING EVIDENCE:
10" WF brs S56°W 18' marked CYC 4 MS 366 BT

FILED September 24, 2025
BAKER COUNTY SURVEYOR
SURVEY NO. 8-37-227

RECORD OF LAND CORNER MONUMENTATION

CORNER #4 CYCLONE QUARTZ CLAIM, MINERAL SURVEY 366,
SITUATED IN SECTION 32, T. 8 S., R. 37 E., W.M.
PAGE 2 OF 2

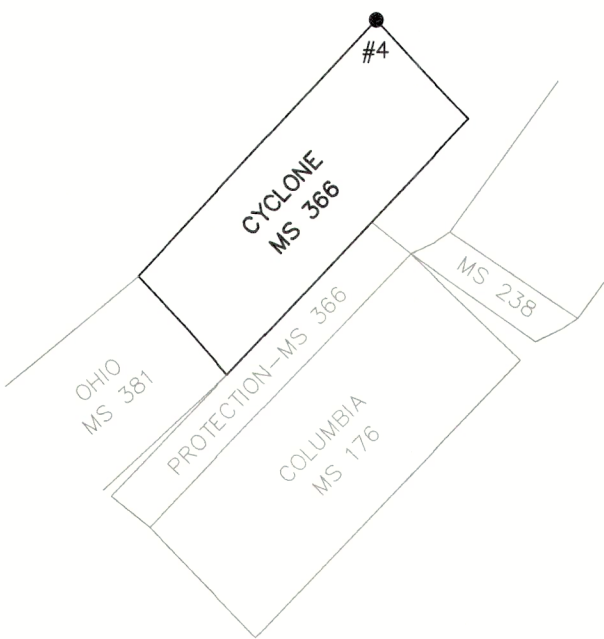

EVIDENCE FOUND: Found Mitchell's unrecorded monument, which is a 1 1/2" galvanized iron pipe with a 2 1/2" brass cap, marked as shown, projecting 1" above ground in a large mound of stone. From which,


- ▶ A white fir, 17" dbh, bears S.57°13'W, 17.83 ft., with fully-healed single blaze (Mitchell BT)
- ▶ A western larch snag, 28" dbh, bears N.85°20'W., 56.6 ft. to face of blaze, 58 ft. to side-center, with opened blaze with scribing 366 B visible (Original BT)

DESCRIPTION OF MONUMENTS AND ACCESSORIES SET AND METHODS USED: I accept Mitchell's brass cap monument as a faithful and accurate perpetuation of the original corner, being harmoniously related to the found accessory evidence, and to other found accepted corners in the area.

- ▶ A white fir, 14" dbh, bears N.15°14'W., 43.52 ft., marked CY4 - 366 in upper blaze and XBT in lower blaze.

I painted a 6 inch red band around each of bearing trees, and also painted the blazes red, and attached new USFS 54-3 and 54-9 signs. Distances to live BT's were measured with a steel tape to a Mag Spike driven in the side-center-right at the root crown of each tree, with an attached 1 1/2" aluminum washer stamped PLS 69454. Used RTK GPS to measure bearings. Bearings are geodetic, based on GPS observation taken at the corner. Set an aluminum guard post S.43°E., 5 ft. with USFS 54-2 and 54-9 signs attached, and another post S.43°W., 4.8 ft. with USFS 54-2 sign attached. See associated Map of Survey dated August 20, 2025 for survey-related information.

CORNER MONUMENT MARKED:

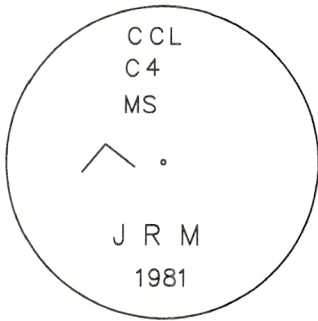

RESTORATION BY, STAMP AND DATE:


Work performed August 28, 2024
Survey completed August 20, 2025

Jason L. Hatfield, PLS

USDA FOREST SERVICE
NORTHEAST OREGON LAND ZONE
1550 Dewey Avenue, Suite A
Baker City, OR 97814
(541) 523-1283

FILED September 24, 2025
BAKER COUNTY SURVEYOR
SURVEY NO. 8-37-227

REGISTERED
PROFESSIONAL
LAND SURVEYOR

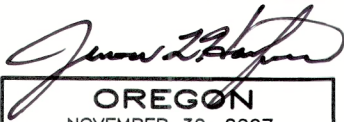
OREGON
NOVEMBER 30, 2007
JASON L. HATFIELD
#69454

EXPIRES: 6/30/2027