

RECORD OF LAND CORNER MONUMENTATION

NORTHERLY-CENTER-END CYCLONE QUARTZ CLAIM, MINERAL SURVEY 366,
SITUATED IN SECTION 32, T. 8 S., R. 37 E., W.M.
PAGE 1 OF 2


ORIGINALLY ESTABLISHED BY: Charles M. Foster, U.S. Deputy Mineral Surveyor

MINERAL SURVEY NUMBER: 366

COMPLETION DATE: August 18, 1899

SUBSEQUENT SURVEYS:

- ▶ Corner search notes by John R. Mitchell, an unlicensed Survey Technician, as documented on U.S. Forest Service corner card dated 8/27/1969
- ▶ Unrecorded remonumentation by John R. Mitchell, an unlicensed Survey Technician, as documented on U.S. Forest Service corner card dated 6/29/1981

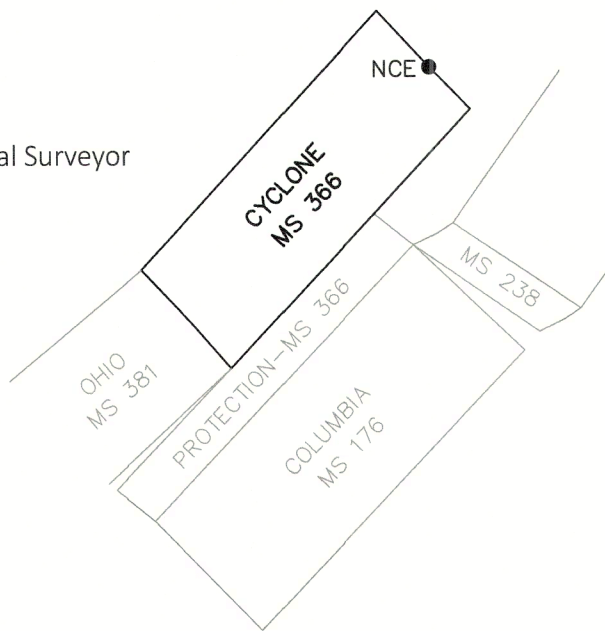

ORIGINAL DESCRIPTION: To Northerly Centre End Post. A Post 4 ½ feet long 4 inches square set 18 inches in the ground with mound of earth scribed N. Centre End Post Sur. No. 366
A Fir 14 inches in dia. bears S.55°E. 18 feet blazed and scribed Sur No 366 B.T.

MITCHELL'S 1969 DESCRIPTION:
DESCRIBE BEARING TREES OR OTHER OFFICIAL ACCESSORIES FOUND
28" WHITE FIR SNAG brs. S.18' with evidence of scribing

MITCHELL'S 1981 DESCRIPTION:
DESCRIBE CORNER MONUMENT FOUND
Rotted post in md of stone

DESCRIBE BEARING TREES OR OTHER OFFICIAL ACCESSORIES FOUND
15" D.F. brs N32°W 10'

NOTE: I Believe the above-mentioned bearing tree to be one which Mitchell *established* not *found*.

MONUMENT: DESCRIBE NEW MONUMENT SET, OR WORK DONE TO PRESERVE EXISTING MONUMENT
2 ½" BC on 1" X 32" gal. pipe set 21" deep in original hole & md marked CYC NEC MS 366 JRM 1981

EVIDENCE FOUND: Found Mitchell's unrecorded monument, which is a 1 ½" galvanized iron pipe with a 2 ½" brass cap, marked as shown, projecting 6" above ground in a 3 ft. diameter mound of stone. From which,


- ▶ A Douglas-fir, 13" dbh, bears S.16°W, 20.62 ft., with fully-healed single blaze (Mitchell BT)
- ▶ A Douglas-fir, 18" dbh, bears N.34°W., 10.0 ft., with partially-healed single blaze with visible scribing (Mitchell BT)

I searched for, but found no remains of the original bearing tree.

FILED September 24, 2025
BAKER COUNTY SURVEYOR
SURVEY NO. 8-37-228

RECORD OF LAND CORNER MONUMENTATION

NORTHERLY-CENTER-END CYCLONE QUARTZ CLAIM, MINERAL SURVEY 366,
SITUATED IN SECTION 32, T. 8 S., R. 37 E., W.M.
PAGE 2 OF 2

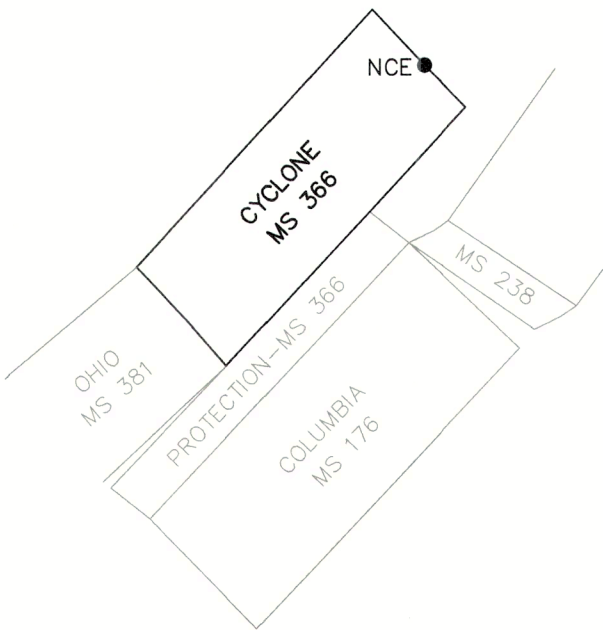


DESCRIPTION OF MONUMENTS AND ACCESSORIES SET AND METHODS USED: I accept Mitchell's brass cap monument as a faithful and accurate perpetuation of the original corner, being harmoniously related to other found accepted corners of the Cyclone Quartz Claim.

From which, **I SCRIBE A NEW BEARING TREE:**

- A ponderosa pine 18" dbh, bears S.67°E., 19.50 ft. marked X in upper blaze, and BT in lower blaze.

CORNER MONUMENT
MARKED:

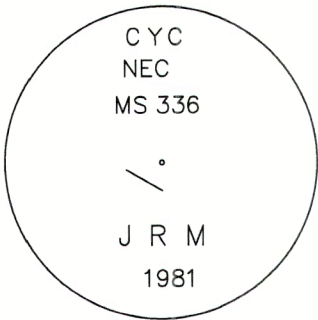

NOTE: The cap is stamped MS 336 but should be MS 366

Painted a 6 inch red band around each bearing tree, and also painted the blazes red, and attached new USFS 54-3 and 54-9 signs. Distances measured with a steel tape to a Mag Spike driven in the side-center-right at the root crown of each tree, with an attached 1 1/2" aluminum washer stamped PLS 69454. Used RTK GPS to measure bearings. Bearings are geodetic, based on GPS observation taken at the corner. Set an aluminum guard post S.45°E., 5 ft. with USFS 54-2 sign attached, and another post N.43°W., 2.3 ft. with USFS 54-2 and 54-9 signs attached. See associated Map of Survey dated August, 2025 for survey-related information.

RESTORATION BY, STAMP AND DATE:

Work performed August 13, 2024
Survey completed August 20, 2025

Jason L. Hatfield, PLS
Spencer B. Jones, Survey Technician

USDA FOREST SERVICE
NORTHEAST OREGON LAND ZONE
1550 Dewey Avenue, Suite A
Baker City, OR 97814
(541) 523-1283

FILED September 24, 2025
BAKER COUNTY SURVEYOR
SURVEY NO. 8-37-228

REGISTERED
PROFESSIONAL
LAND SURVEYOR



OREGON
NOVEMBER 30, 2007
JASON L. HATFIELD
#69454

EXPIRES: 6/30/2027