


RECORD OF LAND CORNER MONUMENTATION

CORNER #2 COLUMBIA QUARTZ CLAIM, MINERAL SURVEY 176,
IDENTICAL WITH CORNER #1 APPOMATTOX QUARTZ CLAIM, MINERAL SURVEY 204,
ALSO IDENTICAL WITH CORNER #2 PROTECTION QUARTZ CLAIM, MINERAL SURVEY 366,
ALSO IDENTICAL WITH CORNER #2 COLUMBIA NO. 2 QUARTZ CLAIM, MINERAL SURVEY 593,
SITUATED IN SECTION 32, T. 8 S., R. 37 E., W.M.
PAGE 1 OF 2

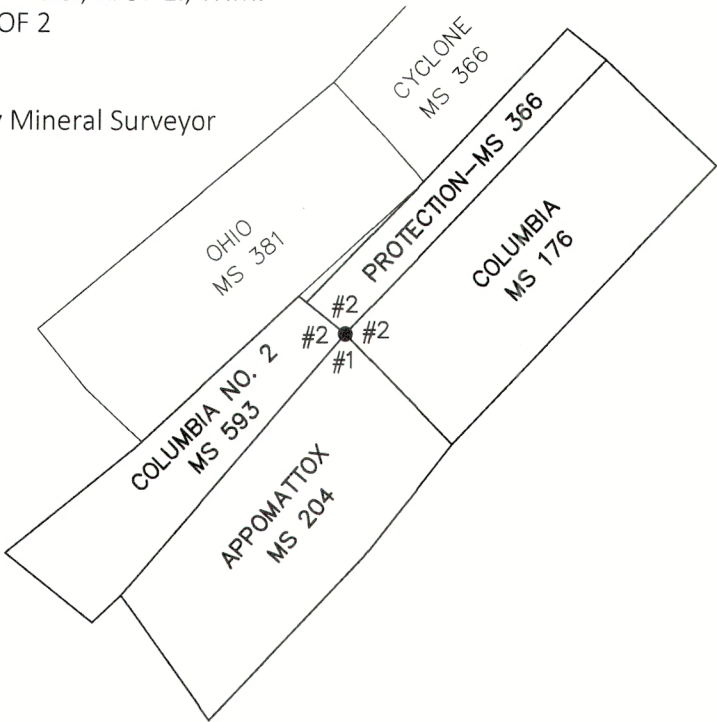

ORIGINALLY ESTABLISHED BY: Charles M. Foster, U.S. Deputy Mineral Surveyor

MINERAL SURVEY NUMBER: 176

COMPLETION DATE: September 7, 1888

SUBSEQUENT SURVEYS:

- ▶ Mineral Survey 204 by Charles M. Foster, U.S. Deputy Mineral Surveyor, completed July 2, 1889
- ▶ Mineral Survey 366 by Charles M. Foster, U.S. Deputy Mineral Surveyor, completed August 18, 1899
- ▶ Mineral Survey 593 by Charles M. Foster, U.S. Deputy Mineral Surveyor, completed September 6, 1904
- ▶ Unrecorded remonumentation by John R. Mitchell, an unlicensed Survey Technician, as documented on U.S. Forest Service corner card dated 7/5/1981

ORIGINAL DESCRIPTION: To post and mound of rocks marked Columbia Mine Sta No. 2 Sur No. 176.

MS 204 DESCRIPTION: Commencing at a pine post 5 ft. long and 6 inches in dia., set 18 inches in the ground with mound of Rocks around same. Which post is Station No. 2 in the official Survey of the Columbia Quartz Claim. Said post being marked "Appomattox Claim Sta. No. 1. Sur. No. 204" and from this post a Mineral Locating Monument, built of Rocks about 5x5 feet & 6 feet high located on the Ridge or divide between Cracker Creek and Fruit Creek. This monument being the one to which the Eureka, Excelsior, and Columbia Quartz Claims are connected. bears N.48°E. 1747 feet distant.

MS 366 DESCRIPTION: To Cor. No. 2. Identical with old cor., and with Cor No. 2 of Survey No. 176 A Post 4 ½ feet long 4 inches square set 18 inches in the ground with mound of earth and stones scribed Cor No 2 - 366
A Pine 20" dia, bears S.23°W 11 ft.
A Tamarac 20" dia bears S85°E 24 ft. each blazed & scribed Cor No. 2 - 366 B.T.

MS 593 DESCRIPTION: Cor. No. 2. Identical with Cor No. 2 Protection Quartz Mining Claim M.S. No. 366; Cor No. 2 Columbia Quartz Mining Claim M.S. No. 176 & Cor. No. 1 Appomattox Quartz Mining Claim M.S. No. 204. A pine post 4 ft. long 4 ins. square, set firmly in the ground, scribed Columbia Mine, Appomattox Cor. 1 - 204; Cor. No. 2 - 366 - Protection & Columbia No. 2 - 2 - 593 Identical with location S.E. cor. post from which
A Tamarack 18 ins in diam. bears S57°W 11.2 ft. dist. scribed Cor. 2 - 366 - B.T.
A fir 10 ins in diam. bears S.14°W. 1.5 ft. dist. blazed & scribed Columbia No. 2 - 2 - 593 B.T.

MITCHELL'S 1981 DESCRIPTION:
DESCRIBE CORNER MONUMENT FOUND
None

DESCRIBE BEARING TREES OR OTHER OFFICIAL ACCESSORIES FOUND
24" pp stump w/ scribing (366 BT) brs S23°W 11'


MONUMENT: DESCRIBE NEW MONUMENT SET, OR WORK DONE TO PRESERVE EXISTING MONUMENT
2 ½" BC on 1" X 32" gal. pipe set 14" deep at cor. pt. in md of stone & earth marked PRO C2 MS 366 JRM 1981 & angle

ACCESSORIES: DESCRIBE NEW BT's WITNESS OBJECTS ETC. ESTABLISHED, OR WORK DONE TO PRESERVE EXISTING EVIDENCE
14" WF brs S36°E 32' marked PRO 2 MS 366 BT
5" L.P.P. brs N56°W 24' marked X BT

FILED September 24, 2015
BAKER COUNTY SURVEYOR
SURVEY NO. 8-37-229

RECORD OF LAND CORNER MONUMENTATION

CORNER #2 COLUMBIA QUARTZ CLAIM, MINERAL SURVEY 176,
IDENTICAL WITH CORNER #1 APPOMATTOX QUARTZ CLAIM, MINERAL SURVEY 204,
ALSO IDENTICAL WITH CORNER #2 PROTECTION QUARTZ CLAIM, MINERAL SURVEY 366,
ALSO IDENTICAL WITH CORNER #2 COLUMBIA NO. 2 QUARTZ CLAIM, MINERAL SURVEY 593,
SITUATED IN SECTION 32, T. 8 S., R. 37 E., W.M.
PAGE 2 OF 2

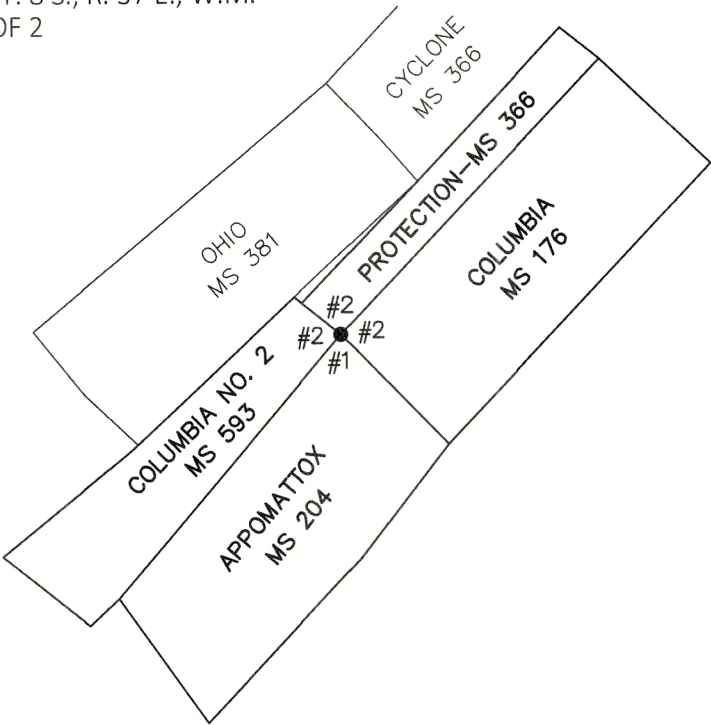

EVIDENCE FOUND: Found a 2 ft. diameter mound of stone with a 2" diameter hole in the center where Mitchell's monument was set. I found no trace of Mitchell's pipe with brass cap. From which:


- ▶ A white fir, 27" dbh, bears S.33°30'E., 32.0 ft. with fully-healed single blaze (Mitchell BT)
- ▶ A 1 3/4" iron pipe, threaded on top, firmly set, projecting 2.5 ft. above ground, bears S.10°W., 7.53 ft. (origin and significance unknown)
- ▶ The rotten remains of a ponderosa pine stump, uprooted, with portion of blaze and partial scribing 66 BT visible. The center of the root wad hole bears S.27°W., 11.5 ft.+/- (MS 366 BT)
- ▶ A lodgepole pine, 8.5" dbh, bears N.58°30'W., 24.1 ft. with fully-healed single blaze (Mitchell BT)

I accept the position of the hole in the center of the mound of stone as the best available evidence of the original corner, being harmoniously related to the found accessory evidence and other found accepted corners in the area.

DESCRIPTION OF MONUMENTS AND ACCESSORIES SET AND METHODS USED: At the corner point, I set a standard USFS 2 1/2" x 30" aluminum pipe with attached 3 1/4" aluminum cap, 28" in the ground. Built a 2.5 ft. diameter mound of stone around the monument to top of cap. Cap is marked as shown below.

CORNER MONUMENT MARKED:

Placed a plastic-encased magnet at the base of the aluminum pipe. Painted a 6 inch red band around each bearing tree, and also painted the healed blazes red, and attached new USFS 54-3 and 54-9 signs. Distances measured with a steel tape to a Mag Spike driven in the side-center at the root crown of each tree, with an attached 1 1/2" aluminum washer stamped PLS 69454. Used RTK GPS to measure bearings. Bearings are geodetic, based on GPS observation taken at the corner. See associated Map of Survey dated August 20, 2025 for survey-related information.

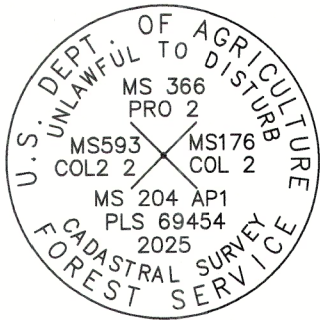

RESTORATION BY, STAMP AND DATE:

Work performed June 5, 2025
Survey completed August 20, 2025

Jason L. Hatfield, PLS

USDA FOREST SERVICE
NORTHEAST OREGON LAND ZONE
1550 Dewey Avenue, Suite A
Baker City, OR 97814
(541) 523-1283

FILED September 24, 2025
BAKER COUNTY SURVEYOR
SURVEY NO. 8-37-229

