

RECORD OF LAND CORNER MONUMENTATION

CORNER #4 PROTECTION QUARTZ CLAIM, MINERAL SURVEY 366,
SITUATED IN SECTION 32, T. 8 S., R. 37 E., W.M.


ORIGINALLY ESTABLISHED BY: Charles M. Foster, U.S. Deputy Mineral Surveyor

MINERAL SURVEY NUMBER: 366

COMPLETION DATE: August 18, 1899

SUBSEQUENT SURVEYS:

- G.L.O. Retracement by Lincoln E. Wilkes, U.S. Cadastral Engineer, under Group No. 107, Approved May 26, 1927

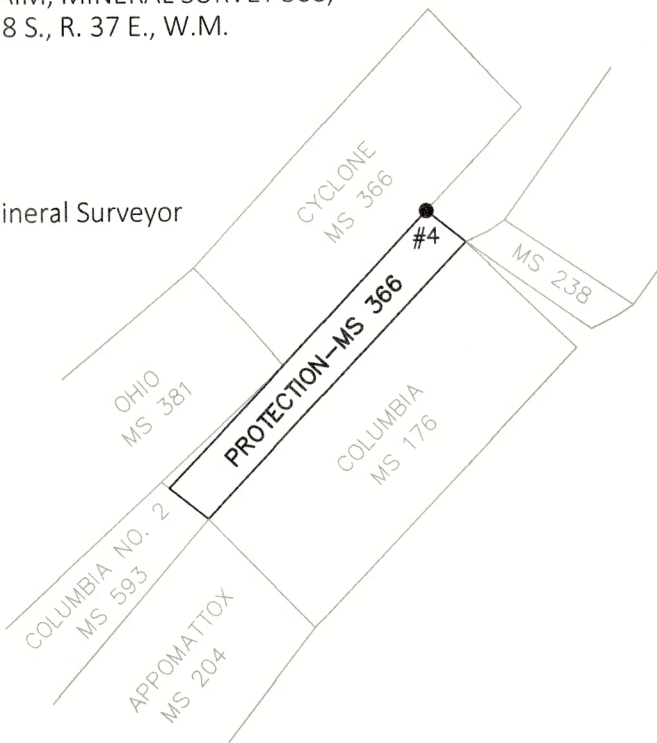

ORIGINAL DESCRIPTION: To corner No. 4. A Post 4 ½ feet long 4 inches square set 18 inches in the ground with mound of earth & stones scribed Cor. No. 4 - 366
A Pine 18" dia bears N22°W 18 ft
A Fir 26" dia bears N.54°W. 42 ft
each blazed and scribed Cor No. 4 - 366 BT

G.L.O. DESCRIPTION: Cor. No. 4, Protection Claim, Sur. No. 366.

EVIDENCE FOUND: After I a diligent search, I found no remaining evidence of the original corner, possibly due to past logging activity. I declare this corner lost, and reestablish it by bearing-bearing intersection.


DESCRIPTION OF MONUMENTS AND ACCESSORIES SET AND METHODS USED: At the corner point, as determined by survey, I set a standard USFS 2 ½" x 30" aluminum pipe with attached 3 ¼" aluminum cap, 24" in the ground. Raised a 2.5 ft. diameter mound of stone around the monument to top of cap. Cap is marked as shown below.

From which, **I SCRIBE NEW BEARING TREES:**

- A ponderosa pine 15" dbh, bears N.57°15'E., 29.71 ft. marked X in upper blaze, and BT in lower blaze.
- A ponderosa pine 14" dbh, bears S.39°15'E., 12.03 ft. marked PRO 4 - 366 in upper blaze, and BT in lower blaze.

Placed a light blue plastic-encased magnet at the base of the aluminum pipe. Painted a 6 inch red band around each bearing tree, and also painted the blazes red, and attached new USFS 54-3 and 54-9 signs. Distances measured with a steel tape to a Mag Spike driven in the side-center-right at the root crown of each tree, with an attached 1 ½" aluminum washer stamped PLS 69454. Used RTK GPS to measure bearings. Bearings are geodetic, based on GPS observation taken at the corner. Set an aluminum guard post N.43°E., 3.8 ft. with USFS 54-2 and 54-9 signs attached, and another post S.52°E., 3.4 ft. with USFS 54-2 sign attached. See associated Map of Survey dated August 20, 2025 for survey-related information.

CORNER MONUMENT
MARKED:

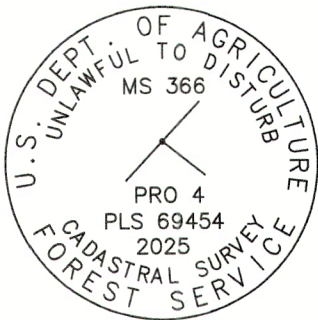

RESTORATION BY, STAMP AND DATE:

Work performed June 2, 2025
Survey completed August 20, 2025

Jason L. Hatfield, PLS

USDA FOREST SERVICE
NORTHEAST OREGON LAND ZONE
1550 Dewey Avenue, Suite A
Baker City, OR 97814
(541) 523-1283

FILED September 24, 2025
BAKER COUNTY SURVEYOR
SURVEY NO. 8-37-231

