

RECORD OF LAND CORNER MONUMENTATION

CORNER #1 ESRASKLE QUARTZ MINING CLAIM, MINERAL SURVEY 591,
SITUATED IN SECTION 32, T. 8 S., R. 37 E., W.M.


ORIGINALLY ESTABLISHED BY: Charles M. Foster, U.S. Deputy Mineral Surveyor

MINERAL SURVEY NUMBER: 591

COMPLETION DATE: September 4, 1904

SUBSEQUENT SURVEYS:

- ▶ G.L.O. Retracement by Lincoln E. Wilkes, U.S. Cadastral Engineer, under Group No. 107, Approved May 26, 1927
- ▶ Corner search notes by John R. Mitchell, an unlicensed Survey Technician, as documented on U.S. Forest Service corner card dated 9/9/1969
- ▶ Unrecorded remonumentation by John R. Mitchell, an unlicensed Survey Technician, as documented on U.S. Forest Service corner card (undated)

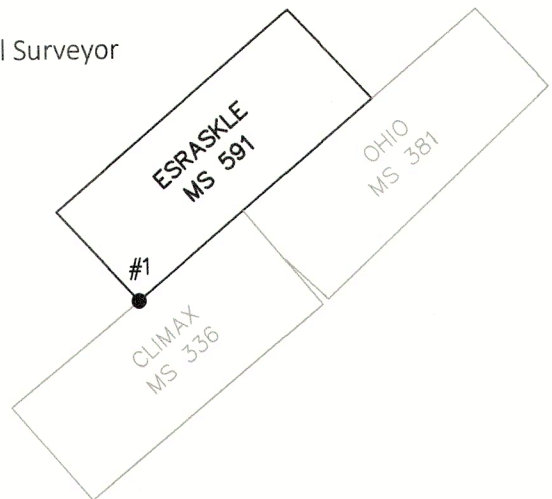

ORIGINAL DESCRIPTION: Beginning at Cor. No. 1 A pine post 4 ft long, 6 ins square set 18 ins in the ground, surrounded with a mound of earth & scribed Esraskle-1-591 Identical with location S.W. cor. post. From which
A pine 8 ins in diam. bears N47°45'W 12 ft. dist. marked Esraskle-1-591-B.T.
A pine 8 ins in diam. bears N24°30'W 9.1 ft. dist. marked Esraskle-1-591-B.T.

G.L.O. DESCRIPTION: Intersect Cor. No. 1, Esraskle Claim Sur. No. 591.

MITCHELL'S 1969 DESCRIPTION:

DESCRIBE BEARING TREES OR OTHER OFFICIAL ACCESSORIES FOUND

10" L.P.P. brs. N.47°45'W. 12 ft.; 10" L.P.P. brs. N.24°30'W. 9.1 ft. both with full scribing

MITCHELL'S 1981 DESCRIPTION:

MONUMENT: DESCRIBE NEW MONUMENT SET, OR WORK DONE TO PRESERVE EXISTING MONUMENT

2 1/2" BC on 1" X 32" gal. pipe set 24" deep in original hole & md of stone marked ES C1 MS591 JRM 1981 & angle


ACCESSORIES: DESCRIBE NEW BT's WITNESS OBJECTS ETC. ESTABLISHED, OR WORK DONE TO PRESERVE EXISTING EVIDENCE: 14" E.S. brs N1°E 23'; 9" WF brs N22 1/2°W 27' both marked ES 1 MS 591 B.T.

EVIDENCE FOUND: Found Mitchell's unrecorded monument, which is a 1 1/2" galvanized iron pipe with a 2 1/2" brass cap, marked as shown, projecting 6" above ground in a 2 ft. diameter mound of stone. From which,

- ▶ An Engelmann spruce, 17" dbh, bears N.04°E., 23.2 ft. with visible scribing in a partially-healed single blaze (Mitchell BT)
- ▶ A lodgepole pine snag, 11" dbh, with heavy lean, bears N.48°W., 12 ft. with scribing
ESRASKLE 1 591 BT visible in an open single blaze (Original BT)
- ▶ A lodgepole pine, 8" diam., dead and down, bears N.25°W., 9 ft. with scribing
ESRASKLE 1 591 BT visible in an open blaze (Original BT)
- ▶ A white fir, 11" dbh, bears N.22°W., 26.8 ft., with single healed blaze (Mitchell BT)

I accept Mitchell's brass cap monument as a faithful and accurate perpetuation of the original corner, being harmoniously related to the found accessory evidence, and to other found accepted corners in the area. Painted a 6 inch red band around each bearing tree, and also painted the blazes red, and attached new USFS 54-3 and 54-9 signs. Distances measured with a steel tape to the side-center of each tree. Used a magnetic compass with 14° East declination to measure bearings. Set an aluminum guard post N.42°W., with USFS 54-2 and 54-9 signs attached. See associated Map of Survey dated August 20, 2025 for survey-related information.

CORNER MONUMENT MARKED:

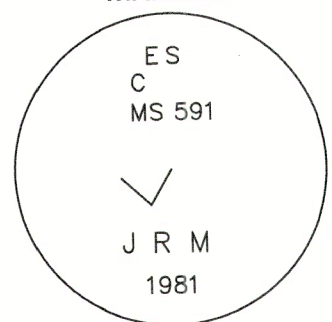

RESTORATION BY, STAMP AND DATE:

Work performed October 5, 2023 & July 15, 2025
Survey completed August 20, 2025

Jason L. Hatfield, PLS
Vince L. Kelly, Survey Technician

USDA FOREST SERVICE
NORTHEAST OREGON LAND ZONE
1550 Dewey Avenue, Suite A
Baker City, OR 97814
(541) 523-1283

FILED September 24, 2025
BAKER COUNTY SURVEYOR
SURVEY NO. 8-37-233

REGISTERED
PROFESSIONAL
LAND SURVEYOR

Jason L. Hatfield
OREGON
NOVEMBER 30, 2007
JASON L. HATFIELD
#69454

EXPIRES: 6/30/2027