

RECORD OF LAND CORNER MONUMENTATION

CORNER #3 ESRASKLE QUARTZ MINING CLAIM, MINERAL SURVEY 591,
SITUATED IN SECTION 32, T. 8 S., R. 37 E., W.M.


ORIGINALLY ESTABLISHED BY: Charles M. Foster, U.S. Deputy Mineral Surveyor

MINERAL SURVEY NUMBER: 591

COMPLETION DATE: September 4, 1904

SUBSEQUENT SURVEYS:

- G.L.O. Retracement by Lincoln E. Wilkes, U.S. Cadastral Engineer, under Group No. 107, Approved May 26, 1927
- Corner search notes by John R. Mitchell, an unlicensed Survey Technician, as documented on U.S. Forest Service corner card dated 9/11/1969

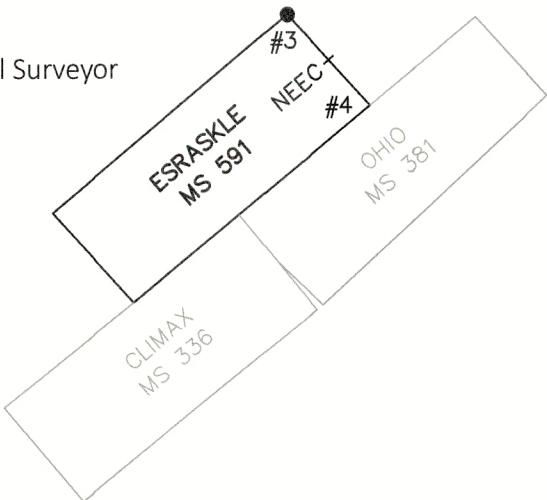

ORIGINAL DESCRIPTION: To Cor. No. 3

A pine post 4 ft long, 4 ins square set 18 ins in the ground, surrounded with a mound of earth & stone and marked Esraskle-3-591-

Location N.W. cor. post bears N42°20'E 4 ft. dist.

A fir 8 ins in diam. bears S30°45'W 28.1 ft. dist. marked Esraskle-3-591-B.T.

A fir 8 ins in diam. bears S75°20'W 26.4 ft. dist. marked Esraskle-3-591-B.T.

G.L.O. DESCRIPTION: To cor. No. 3, as described.

MITCHELL'S 1969 DESCRIPTION:

DESCRIBE CORNER LOCATION RELATIVE TO NEAR-BY FEATURES, ALSO HOW TO REACH CORNER

I believe the evidence here has been destroyed by the clearing of the power line R/W. However I ran in from 2 directions & am satisfied there will be no trespass if the cutting line is followed.

EVIDENCE FOUND: After a diligent search, I found no remaining evidence of the original corner. The search area showed signs of significant disturbance from logging activity and the construction of a power line and access road. I declare this corner lost, and reestablish it as follows. I determined the bearing and distance between Corner #4 and the Northeast-End-Center of Esraskle to be N.41°27'50"W., 300.69 ft. I measured this same bearing and distance from the Northeast-End-Center to establish Corner #3. I chose this method over a Grant Boundary Adjustment, as I believe it places the corner closer to the original position.

DESCRIPTION OF MONUMENTS AND ACCESSORIES SET AND METHODS USED: At the corner point, I set a standard USFS 2 1/2" x 30" aluminum pipe with attached 3 1/4" aluminum cap, 24" in the ground. Raised a 2 ft. diameter mound of stone around the monument to top of cap. Cap is marked as shown below.

CORNER MONUMENT MARKED:

From which, I SCRIBE A NEW BEARING TREE:

- A lodgepole pine, 13" dbh, bears N.44°E., 33.00 ft. marked ESR3 - 591 in upper blaze, and XBT in lower blaze.

Also from which, I SET A NEW REFERENCE POINT:

- A 5/8"x 24" iron pin, bears N.82°32'W., 15.28 ft., with attached 2" aluminum cap marked RP 1 2025 PLS 69454



Placed a pink plastic-encased magnet at the base of the aluminum pipe. Painted a 6 inch red band around the bearing tree, and also painted the blazes red, and attached USFS 54-3 and 54-9 signs. Used RTK GPS to measure accessories. Bearings are geodetic, based on GPS observation taken at the corner. Distance to BT measured to a Mag Spike driven in the side-center-right at the root crown of the tree, with an attached 1 1/2" aluminum washer stamped PLS 69454. Set an aluminum guard post S.41°E., 3 ft., with USFS 54-2 and 54-9 signs attached, and another S.41°W., 3.3 ft. with USFS 54-2 sign attached. See associated Map of Survey dated August 20, 2025 for survey-related information.

RESTORATION BY, STAMP AND DATE:

Work performed July 23, 2025
Survey completed August 20, 2025

Jason L. Hatfield, PLS
Vince L. Kelly, Survey Technician

USDA FOREST SERVICE
NORTHEAST OREGON LAND ZONE
1550 Dewey Avenue, Suite A
Baker City, OR 97814
(541) 523-1283

FILED September 24, 2025
BAKER COUNTY SURVEYOR
SURVEY NO. 8-37-235

REGISTERED
PROFESSIONAL
LAND SURVEYOR

Jason L. Hatfield
OREGON
NOVEMBER 30, 2007
JASON L. HATFIELD
#69454

EXPIRES: 6/30/2027