RECORD OF LAND CORNER MONUMENTATION

NORTHEAST-END-CENTER ESRASKLE QUARTZ MINING CLAIM, MINERAL SURVEY 591,
SITUATED IN SECTION 32, T. 8 S., R. 37 E., W.M.

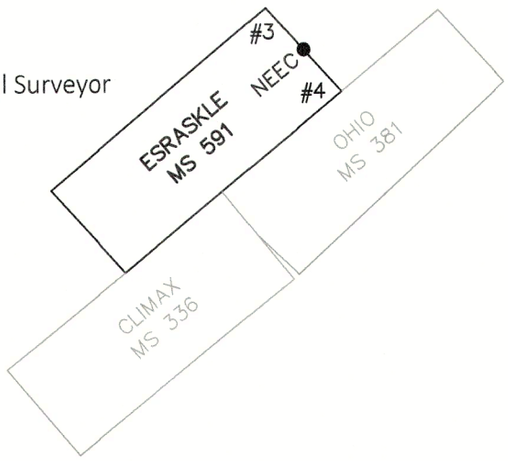

ORIGINALLY ESTABLISHED BY: Charles M. Foster, U.S. Deputy Mineral Surveyor

MINERAL SURVEY NUMBER: 591

COMPLETION DATE: September 4, 1904

SUBSEQUENT SURVEYS: N/A

ORIGINAL DESCRIPTION: To the N.E. end cen. post. A pine post 4 ft long, 4 ins square, set 18 ins in the ground, surrounded with a mound of earth & stone and marked Esraskle N.E. end cen. M.S. 591 Identical with location N.E. end cen. post, at discovery cut.

On Page 7 under Expenditures:

Improvement No. 2: An open cut which bears from the N.E. end cen. post S31°21'W 50 ft. dist 4X10 ft. 7 ft. face....

EVIDENCE FOUND: I searched for, but found no trace of the original monument possibly due to the construction of a power line and access road directly uphill from the corner. The corner position however, is not lost. I searched for and found Improvement No. 2 as described in the original survey. I reestablished the corner by measuring the record bearing and distance of N.31°21'E., 50.00 ft. from the center of the exposed rock face of Improvement No. 2. The resultant corner position is harmoniously related to the found accepted monument at Corner #4 of Esraskle.

DESCRIPTION OF MONUMENTS AND ACCESSORIES SET AND METHODS USED: At the corner point, as determined by survey, I set a standard USFS 2 ½" x 30" aluminum pipe with attached 3 ¼" aluminum cap, 18" in the ground to bedrock. Raised a 3 ft. diameter mound of stone around the monument to top of cap. Cap is marked as shown below.

From which, **I SCRIBE A NEW BEARING TREE:**

- A ponderosa pine, 9" dbh, bears N.72°55'E., 35.68 ft. marked *ESR-NEEC-591* in upper blaze, and *XBT* in lower blaze.

Also from which, **I SET A NEW REFERENCE POINT:**

- A 5/8"x 24" iron pin, bears S.50°09'E., 20.98 ft., with attached 2" aluminum cap marked *RP 1 2025 PLS 69454*

CORNER MONUMENT MARKED:

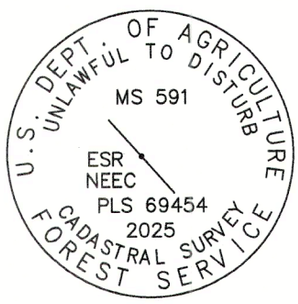

Placed a pink plastic-encased magnet at the base of the aluminum pipe. Painted a 6 inch red band around the bearing tree, and also painted the blazes red, and attached USFS 54-3 and 54-9 signs. Used RTK GPS to measure accessories. Bearings are geodetic, based on GPS observation taken at the corner. Distance to BT measured to a Mag Spike driven in the side-center-right at the root crown of the tree, with an attached 1 ½" aluminum washer stamped *PLS 69454*. Set an aluminum guard post S.41°E., 4 ft., with USFS 54-2 and 54-9 signs attached. See associated Map of Survey dated August 20, 2025 for survey-related information.

RESTORATION BY, STAMP AND DATE:

Work performed July 23, 2025
Survey completed August 20, 2025

Jason L. Hatfield, PLS
Vince L. Kelly, Survey Technician

USDA FOREST SERVICE
NORTHEAST OREGON LAND ZONE
1550 Dewey Avenue, Suite A
Baker City, OR 97814
(541) 523-1283

FILED September 24, 2025
BAKER COUNTY SURVEYOR
SURVEY NO. 8-37-236

EXPIRES: 6/30/2027