

RECORD OF LAND CORNER MONUMENTATION


CORNER #2 APPOMATTOX QUARTZ CLAIM, MINERAL SURVEY 204,
IDENTICAL WITH CORNER #3 GOLCONDA QUARTZ CLAIM, MINERAL SURVEY 348,
ALSO IDENTICAL WITH CORNER #1 COLUMBIA NO. 2 QUARTZ CLAIM, MINERAL SURVEY 593,
SITUATED IN SECTION 32, T. 8 S., R. 37 E., W.M.
PAGE 1 OF 2

ORIGINALLY ESTABLISHED BY: Charles M. Foster, U.S. Deputy Mineral Surveyor
MINERAL SURVEY NUMBER: 204

COMPLETION DATE: July 2, 1889

SUBSEQUENT SURVEYS:

- ▶ Mineral Survey 348 by Arthur Philbrick, U.S. Deputy Mineral Surveyor, completed July 13, 1898
- ▶ Mineral Survey 593 by Charles M. Foster, U.S. Deputy Mineral Surveyor, completed September 6, 1904
- ▶ Corner search notes by John R. Mitchell, an unlicensed Survey Technician, as documented on U.S. Forest Service corner card dated 9/5/1969
- ▶ Unrecorded remonumentation by John R. Mitchell, an unlicensed Survey Technician, as documented on U.S. Forest Service corner card (undated)
- ▶ Survey by Leland Myers, PLS #699, map filed December 22, 2003, as Survey No. 8-37-135 in the Baker County Surveyor's office

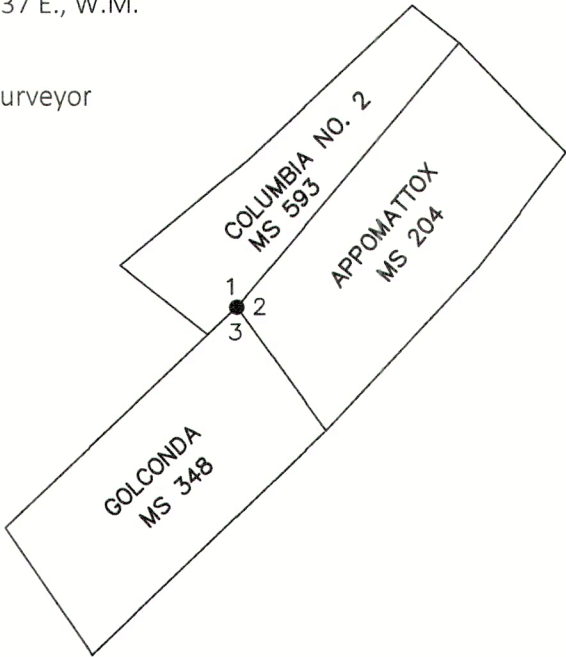

ORIGINAL DESCRIPTION: Set Blk. Pine Post 5 ft long & 6 in. dia, 18 in. in ground and raised mound of rock around it marked Appomattox Mine Sta. No. 2 Sur. No. 204.

MS 348 DESCRIPTION: To cor. No. 3 Identical with Cor No. 2 Appomattox Lode Sur No. 204 also identical with Golconda location corner. Set a new pine post in same mound 4 ft. long 4 ins. square 2 ft. in the ground with mound of earth scribed G-3-348 whence,
A black pine 6 ins diam bears N38°15'E 17.65 ft.
A tamarack 12 ins in diam bears S6°30'E 19.1 ft. Each blazed, and scribed G-3-348 B.T.

MS 593 DESCRIPTION: Beginning at cor. No. 1 Identical with cor. No. 2 of the Appomattox Quartz Mining Claim M.S. No. 204 & cor. No. 3 of the Golconda Quartz Mining Claim M.S. No. 348.
A pine post 4 ft. long, 6 ins square, set 18 ins. in the ground, surrounded with a mound of earth. Scribed Appomattox cor. 2 - Sur 204; Golconda cor. 3 sur. 348 & Columbia No. 2 - 1 - 593
From which
A fir 18 ins in Diam. bears N5°50'W 16.4 ft Dist. blazed & scribed B.T.
A pine 10 ins in Diam. bears N37°15'E 17.7 ft Dist., blazed & scribed Cor. 2 - Sur. 204 - B.T.
A tamarack 14 ins in Diam. bears S7°40'E 19.3 ft Dist., blazed & scribed C - 3 - 348 - B.T.
A tamarack 12 ins in Diam. bears S29°20'W 11.4 ft Dist., blazed & scribed B.T.

MITCHELL'S 1969 DESCRIPTION:
DESCRIBE CORNER MONUMENT FOUND
mound of stone

DESCRIBE BEARING TREES OR OTHER OFFICIAL ACCESSORIES FOUND
18" L.P.P. brs. N.37°E. 17.7 ft. with full scribing.
26" W.F. brs. N.5°50'W. 16.4 ft. scribing grown over


MITCHELL'S 1981 DESCRIPTION:
MONUMENT: DESCRIBE NEW MONUMENT SET, OR WORK DONE TO PRESERVE EXISTING MONUMENT
2 1/2" BC on 1" X 32" gal. pipe set 26" deep in original hole & md of stone & earth marked APP C2 MS 204 JRM 1981 & angle

ACCESSORIES: DESCRIBE NEW BT's WITNESS OBJECTS ETC. ESTABLISHED, OR WORK DONE TO PRESERVE EXISTING EVIDENCE
7" LPP brs S77°W 19 1/2'
8" WF brs N87°W 18' both marked APP 2 MS 204 BT

FILED September 24, 2025
BAKER COUNTY SURVEYOR
SURVEY NO. 8-37-238

RECORD OF LAND CORNER MONUMENTATION

CORNER #2 APPOMATTOX QUARTZ CLAIM, MINERAL SURVEY 204,
IDENTICAL WITH CORNER #3 GOLCONDA QUARTZ CLAIM, MINERAL SURVEY 348,
ALSO IDENTICAL WITH CORNER #1 COLUMBIA NO. 2 QUARTZ CLAIM, MINERAL SURVEY 593,
SITUATED IN SECTION 32, T. 8 S., R. 37 E., W.M.
PAGE 2 OF 2

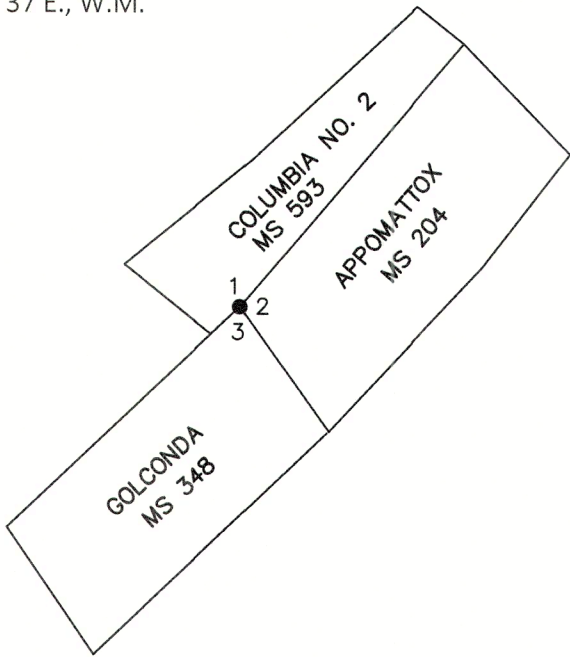

MYERS' 2003 DESCRIPTION:

Map indicates that Myers found and accepted Mitchell's monument and restamped it with his own markings.

EVIDENCE FOUND: Found Mitchell's monument, which is a 1 ½" galvanized iron pipe with a 2 ½" brass cap, with Mitchell's markings obliterated by Myers, marked as shown, flush with ground in a 2.5 ft. diameter mound of stone. From which,


- ▶ A lodgepole pine, 18" diameter, dead and down, with scribing C3 - 348 - BT visible in a partially-healed single blaze. The tree was found pushed downhill and out of it's original position by heavy equipment (MS 348 BT)
- ▶ A lodgepole pine, 8" dbh, bears S.73°W., 19.20 ft., with visible scribing in a partially-healed single blaze (Mitchell BT)
- ▶ A white fir, 12" dbh, bears S.87°W., 17.75 ft., with fully-healed single blaze (Mitchell BT)
- ▶ A white fir, 39" dbh, bears N.02°W., 16.5 ft., with fully-healed single blaze (MS 593 BT)

DESCRIPTION OF MONUMENTS AND ACCESSORIES SET AND METHODS USED:

I accept Mitchell's brass cap monument as a faithful and accurate perpetuation of the original corner, being harmoniously related to the found accessory evidence, and to other found accepted corners in the area.

I attached new USFS 54-3 and 54-9 signs to all live BT's. Distances to Mitchell's bearing trees were measured with a steel tape to a 60d galvanized spike with attached 1 ½" diameter aluminum washer marked *PLS 699* found driven side-center-left at the root crown of each tree. Distance to the MS 593 tree measured to the side-center. Used RTK GPS to measure bearings. Bearings are geodetic, based on GPS observation taken at the corner. See associated Map of Survey dated August 20, 2025 for survey-related information.

CORNER MONUMENT MARKED:

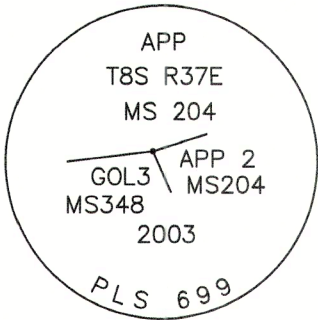

RESTORATION BY, STAMP AND DATE:

Work performed June 12, 2025
Survey completed August 20, 2025

Jason L. Hatfield, PLS

USDA FOREST SERVICE
NORTHEAST OREGON LAND ZONE
1550 Dewey Avenue, Suite A
Baker City, OR 97814
(541) 523-1283

FILED September 24, 2025
BAKER COUNTY SURVEYOR
SURVEY NO. 8-37-238

