

RECORD OF LAND CORNER MONUMENTATION

CORNER #3 COLUMBIA NO. 2 QUARTZ CLAIM, MINERAL SURVEY 593,
SITUATED IN SECTION 32, T. 8 S., R. 37 E., W.M.


ORIGINALLY ESTABLISHED BY: Charles M. Foster, U.S. Deputy Mineral Surveyor

MINERAL SURVEY NUMBER: 593

COMPLETION DATE: September 6, 1904

SUBSEQUENT SURVEYS:

- Unrecorded remonumentation by John R. Mitchell, an unlicensed Survey Technician, as documented on U.S. Forest Service corner card dated 7/5/1981

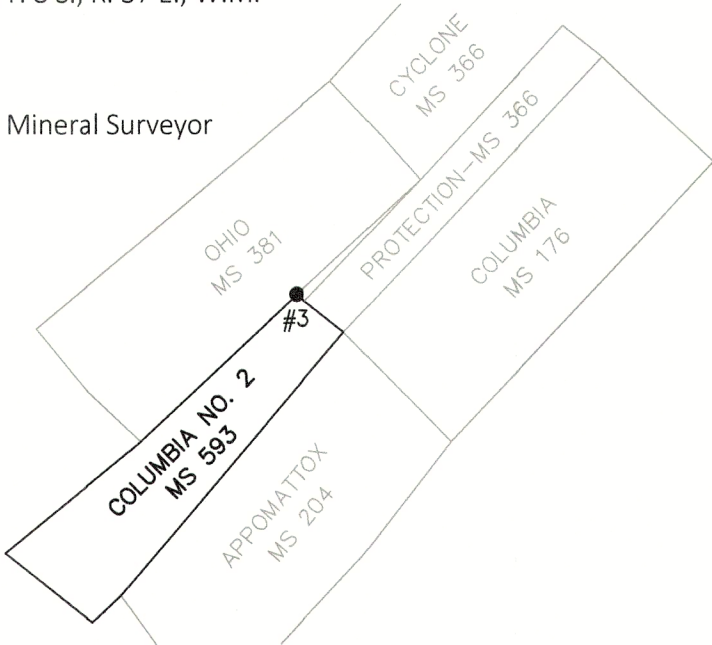

ORIGINAL DESCRIPTION: To Cor. No. 3 - On line 1-2 of the Ohio Quartz Mining Claim M.S. No. 381 A pine post 4 ft. long, 4 ins. square set 18 ins. in the ground surrounded with a mound of earth & scribed Columbia No. 2-3-593

MITCHELL'S 1981 DESCRIPTION:

DESCRIBE CORNER MONUMENT FOUND

Rotted post in Md of stone

MONUMENT: DESCRIBE NEW MONUMENT SET, OR WORK DONE TO PRESERVE EXISTING MONUMENT

2 1/2" BC on 1" X 32" gal. pipe set 27" deep in original hole & md marked COL2 C3 MS 593 JRM 1981 & angle

ACCESSORIES: DESCRIBE NEW BT's WITNESS OBJECTS ETC. ESTABLISHED, OR WORK DONE TO PRESERVE EXISTING EVIDENCE

11" DF brs N1°W 15'

7" WF brs S88°W 32' both marked COL2 MS 593 B.T.

EVIDENCE FOUND: Found Mitchell's unrecorded monument, which is a 1 1/2" galvanized iron pipe with a 2 1/2" brass cap, marked as shown, projecting 3" above ground in a 2 ft. diameter mound of stone, with a steel fence post with USFS 54-9 sign attached, set NE and alongside the mound. From which,


- A Douglas-fir, 19" dbh, bears N.01°E., 14.42 ft. with fully-healed single blaze (Mitchell BT)
- A white fir, 16" dbh, bears S.84°W., 33.0 ft. with fully-healed single blaze (Mitchell BT)

DESCRIPTION OF MONUMENTS AND ACCESSORIES SET AND METHODS USED:

I accept Mitchell's brass cap monument as a faithful and accurate perpetuation of the original corner, being harmoniously related to other known corners of Mineral Survey No. 593.

I attached new USFS 54-3 and 54-9 signs to the bearing trees. Distances measured with a steel tape to a Mag Spike driven in the side-center-right at the root crown of each tree, with an attached 1 1/2" aluminum washer stamped PLS 69454. Used RTK GPS to measure bearings. Bearings are geodetic, based on GPS observation taken at the corner. See associated Map of Survey dated August 20, 2025 for survey-related information.

CORNER MONUMENT MARKED:

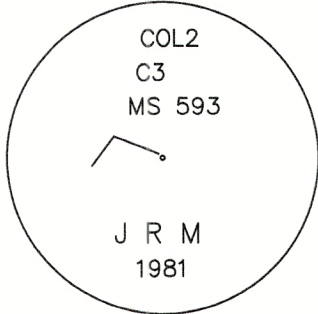

RESTORATION BY, STAMP AND DATE:

Work performed October 15, 2024
Survey completed August 20, 2025

Jason L. Hatfield, PLS

USDA FOREST SERVICE
NORTHEAST OREGON LAND ZONE
1550 Dewey Avenue, Suite A
Baker City, OR 97814
(541) 523-1283

FILED September 24, 2025
BAKER COUNTY SURVEYOR
SURVEY NO. 8-37-239

REGISTERED
PROFESSIONAL
LAND SURVEYOR


OREGON
NOVEMBER 30, 2007
JASON L. HATFIELD
#69454

EXPIRES: 6/30/2027