

RECORD OF LAND CORNER MONUMENTATION

CORNER #2 OHIO QUARTZ CLAIM, MINERAL SURVEY 381,
IDENTICAL WITH CORNER #4 COLUMBIA NO. 2 QUARTZ CLAIM, MINERAL SURVEY 593,
SITUATED IN SECTION 32, T. 8 S., R. 37 E., W.M.


ORIGINALLY ESTABLISHED BY: Charles M. Foster, U.S. Deputy Mineral Surveyor

MINERAL SURVEY NUMBER: 381

COMPLETION DATE: December 28, 1899

SUBSEQUENT SURVEYS:

- Mineral Survey 593 by Charles M. Foster, U.S. Deputy Mineral Surveyor, completed September 6, 1904
- Unrecorded remonumentation by John R. Mitchell, an unlicensed Survey Technician, as documented on U.S. Forest Service corner card dated 6/12/1981

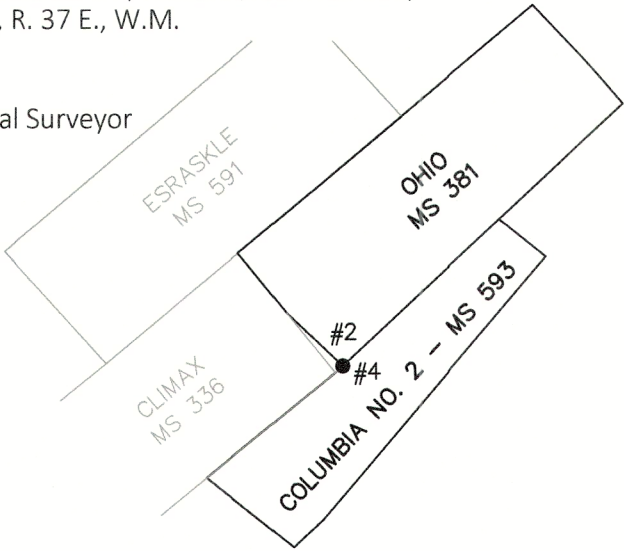

ORIGINAL DESCRIPTION: A pine post 4 ft. long, 4 ins. square set 18 ins. in the ground, scribed 2-381, whence
A pine 8 ins. dia. bears S12°15'E 10 ft. Dist., blazed and scribed No. 2-381, B.T.
A pine 12 ins. dia. bears N27°E 20.5 ft. Dist., blazed and scribed No. 2-381, B.T.

MS 593 DESCRIPTION: To cor. No. 4 Identical with Cor No. 2 of the Ohio Claim M.S. No. 381 previously described.
Marked said post Col No. 2-3-593 & the said witness trees marked Col. No. 2-3-593 B.T.

MITCHELL'S 1981 DESCRIPTION:

DESCRIBE CORNER MONUMENT FOUND: Rotted post in Md of stone

MONUMENT: DESCRIBE NEW MONUMENT SET, OR WORK DONE TO PRESERVE EXISTING MONUMENT

2 1/2" BC on 1" X 32" gal. pipe set 24" deep in old hole & md. marked COL 2 C4 MS 593 JRM 1981 & angle

ACCESSORIES: DESCRIBE NEW BT's WITNESS OBJECTS ETC. ESTABLISHED, OR WORK DONE TO PRESERVE EXISTING

EVIDENCE: 14" WF brs S12°E 26' marked CO 2 4 MS 593 BT

EVIDENCE FOUND: Found Mitchell's unrecorded monument, which is a 1 1/2" galvanized iron pipe with a 2 1/2" brass cap, marked as shown, projecting 5" above ground in a 2 ft. diameter mound of stone. From which,


- A white fir, 19" dbh, bears S.13°E., 29.3 ft. with fully-healed single blaze (Mitchell BT)
- Corner #2 of the Climax Lode Claim, M.S. 336, identical with Corner #5 of the Columbia No. 2 Quartz Claim, M.S. 593, monumented with a 1 1/2" galvanized iron pipe with a 2 1/2" brass cap established by J.R. Mitchell in 1981 (unrecorded), bears S.50°58'27"W., 13.47 ft.

DESCRIPTION OF MONUMENTS AND ACCESSORIES SET AND METHODS USED:

I accept Mitchell's brass cap monument as a faithful and accurate perpetuation of the original corner, being harmoniously related to other known corners in the area.

I did not paint the bearing tree. Distance to bearing tree measured with a steel tape to the side-center-right at the root crown of the tree. Used RTK GPS to measure bearings. Bearings are geodetic, based on GPS observation taken at the corner. See associated Map of Survey dated August 20, 2025 for survey-related information.

CORNER MONUMENT MARKED:

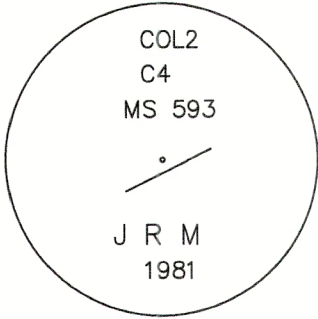

RESTORATION BY, STAMP AND DATE:

Work performed August 26, 2024
Survey completed August 20, 2025

Jason L. Hatfield, PLS

USDA FOREST SERVICE
NORTHEAST OREGON LAND ZONE
1550 Dewey Avenue, Suite A
Baker City, OR 97814
(541) 523-1283

FILED September 24, 2025
BAKER COUNTY SURVEYOR
SURVEY NO. 8-37-240

