

RECORD OF LAND CORNER MONUMENTATION

CORNER #2 CLIMAX LODGE CLAIM, MINERAL SURVEY 336,
IDENTICAL WITH CORNER #5 COLUMBIA NO. 2 QUARTZ CLAIM, MINERAL SURVEY 593,
SITUATED IN SECTION 32, T. 8 S., R. 37 E., W.M.


ORIGINALLY ESTABLISHED BY: Charles M. Foster,
U.S. Deputy Mineral Surveyor

MINERAL SURVEY NUMBER: 336

COMPLETION DATE: July 10, 1897

SUBSEQUENT SURVEYS:

- ▶ Mineral Survey 593 by Charles M. Foster, U.S. Deputy Mineral Surveyor, completed September 6, 1904
- ▶ Unrecorded remonumentation by John R. Mitchell, an unlicensed Survey Technician, as documented on U.S. Forest Service corner card dated 6/10/1981

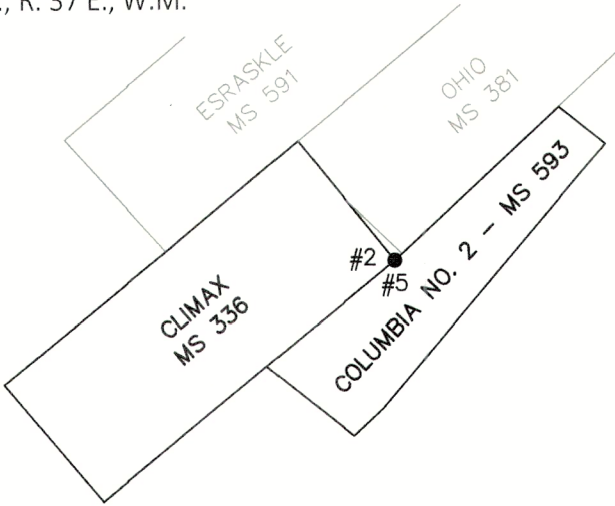

ORIGINAL DESCRIPTION: To Cor. No. 2 A Post 4 1/2 ft. long 4 inches square set 18 inches in the ground with mound of earth scribed "2-336 Climax Claim"

A Blk Fir 14 inches dia., Blazed and scribed 2-336 Climax Claim BT bears S81°30'W 14 ft. distant.

A Tamarac 14 inches dia. Blazed and scribed "BT. 2-336 Climax Claim" bears S.5°W. 20 ft. distant.

MS 593 DESCRIPTION: To cor. No. 5 Identical with Cor No. 2 of the Climax Quartz Mining Claim M.S. No. 336 A pine post 4 ins square, set firmly in the ground, surrounded with a mound of earth & marked Climax - Cor - 2 - 336 & Columbia No. 2 - Cor. 5 - 593

A fir 14 ins in Diam. bears S81°30'W 14 ft. dist. marked Climax - Cor 2 - 336 - B.T. & COL. No. 2. - 5 - 593 - B.T.

A tamarack 14 ins in diam. bears S.5°W. 20 ft. dist. marked Climax - Cor. 2 - 5 - 593 - B.T.

MITCHELL'S 1981 DESCRIPTION:

DESCRIBE CORNER MONUMENT FOUND: Rotting post w/scribing in md of E & S

DESCRIBE BEARING TREES OR OTHER OFFICIAL ACCESSORIES FOUND: 30" gr. WF brs S89°W 14' w/H.B.; dead 16" WL brs S5°W 20' w/H.B.

MONUMENT: DESCRIBE NEW MONUMENT SET, OR WORK DONE TO PRESERVE EXISTING MONUMENT:

2 1/2" BC on 1" X 32" gal. pipe set 27" deep in original & md marked COL 2 C5 MS 593 JRM 1981 & angle


ACCESSORIES: DESCRIBE NEW BT's WITNESS OBJECTS ETC. ESTABLISHED, OR WORK DONE TO PRESERVE EXISTING EVIDENCE: 9" WF brs S14°W 19' marked CO 2 MS 593 BT

EVIDENCE FOUND: Found Mitchell's unrecorded monument, which is a 1 1/2" galvanized iron pipe with a 2 1/2" brass cap, marked as shown, projecting 5" above ground in a 1.5 ft. diameter mound of stone. From which,

- ▶ Corner #2 of the Ohio Quartz Claim, M.S. 381, identical with Corner #4 of the Columbia No. 2 Quartz Claim, M.S. 593, monumented with a 1 1/2" galvanized iron pipe with a 2 1/2" brass cap established by J.R. Mitchell in 1981 (unrecorded), bears N.50°58'27"E., 13.47 ft.
- ▶ A rotten white fir stump, 30"+/- diameter, 2 ft. tall (sawn), bears S.82°W., 14 ft. (Original BT)
- ▶ A dead and down white fir, 9" diameter, with open blaze and visible scribing, original position could not be determined (Mitchell BT)
- ▶ A dead and down western larch (wind-thrown), 14" diameter (without bark), with partially healed blaze. The stump hole of which bears S.05°W., 19.7 ft. +/- to center. I cut away the overgrowth on the bole to reveal scribing:
COR NO. 2 CLIMAX CLAIM (Original BT)

I accept Mitchell's brass cap monument as a faithful and accurate perpetuation of the original corner, being harmoniously related to the found accessory evidence, and to other found accepted corners in the area. Accessories were measured using RTK GPS. Bearings are geodetic, based on GPS observation taken at the corner. See associated Map of Survey dated August 20, 2025 for survey-related information.

CORNER MONUMENT
MARKED:

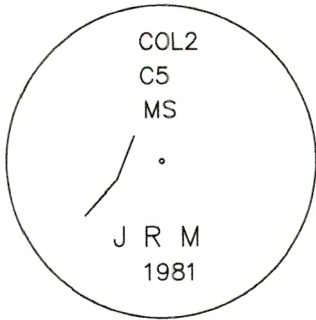



RESTORATION BY, STAMP AND DATE:

Work performed August 26, 2024
Survey completed August 20, 2025

Jason L. Hatfield, PLS

USDA FOREST SERVICE
NORTHEAST OREGON LAND ZONE
1550 Dewey Avenue, Suite A
Baker City, OR 97814
(541) 523-1283

FILED September 24, 2025
BAKER COUNTY SURVEYOR
SURVEY NO. 8-37-241

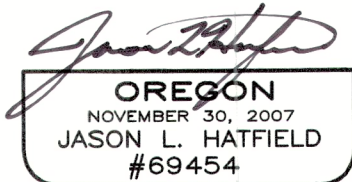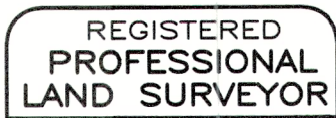

EXPIRES: 6/30/2027