

RECORD OF LAND CORNER MONUMENTATION

CORNER #6 COLUMBIA NO. 2 QUARTZ CLAIM, MINERAL SURVEY 593,
SITUATED IN SECTION 32, T. 8 S., R. 37 E., W.M.
PAGE 1 OF 2


ORIGINALLY ESTABLISHED BY: Charles M. Foster, U.S. Deputy Mineral Surveyor

MINERAL SURVEY NUMBER: 593

COMPLETION DATE: September 6, 1904

SUBSEQUENT SURVEYS:

- G.L.O. Retracement by Lincoln E. Wilkes, U.S. Cadastral Engineer, under Group No. 107, Approved May 26, 1927
- Corner search notes by John R. Mitchell, an unlicensed Survey Technician, as documented on U.S. Forest Service corner card dated 9/9/1969

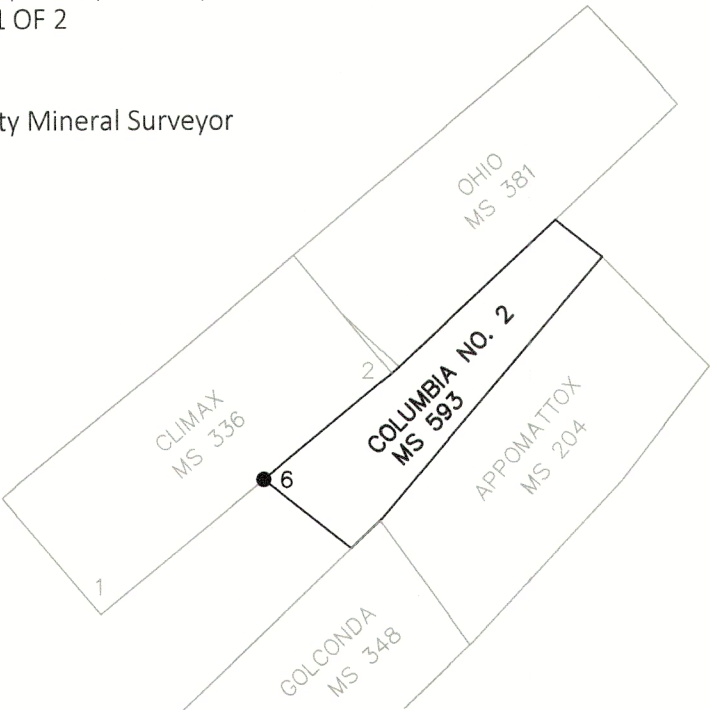

ORIGINAL DESCRIPTION: To Cor. No. 6 A pine post 4 ft. long 5 ins. square, set 18 ins. in the ground surrounded with a mound of earth & scribed Col. No. 2-6-593 from which Location N.W. cor post bears S50°50'W 26 ft. dist. no trees available for witnesses.

G.L.O. DESCRIPTION: To cor. No. 6, as described

MITCHELL'S 1969 DESCRIPTION:

DESCRIBE CORNER MONUMENT FOUND
Post, rotted but distinguishable

DESCRIBE CORNER LOCATION RELATIVE TO NEAR-BY FEATURES, ALSO HOW TO REACH CORNER

The surveyor blazed a tree here also () and I tied this in with the south line of M.S. 336 to the point where I am satisfied with the location. the surveyor was very careful to make reference to the exact dist. and bearing from this point to both cors. on this line of the Climax Claim. Apparently to justify not scribing one of the many available trees which he, here again, maintained did not exist.

EVIDENCE FOUND: I searched for, but found no remains of the original monument or the location corner. I believe the monument was destroyed by construction activities, as the search area falls in the cut bank of an existing road. I found the following unrecorded evidence in the vicinity of the corner:


- A 1"x1"x 48" wood stake driven in the ground, which bears S.88°W., 23 ft. from the calculated corner position. I have found similar stakes near other mineral corners around the Bourne area, but their origin and significance is unknown.
- A 13" dbh lodgepole pine with two old National Forest Boundary signs attached and grown over, which were oriented perpendicular to one another, as if to indicate the corner location. Its location however, is suspect, as it bears N.75°W., 29 ft. from the calculated corner position.
- A 27" dbh grand fir with healed blaze marks on the NE, SW, and NW sides of the tree, which bears approximately S.74°W., 37 ft. I presume this to be the same blazed tree that Mitchell reported finding.

After careful evaluation, I do not accept the stake or either of the trees as sufficient evidence of the original corner. There is no official record of any of these objects, and it is unknown if or how they may relate to the corner. Furthermore, the positional relationship of each of these objects to other found controlling corners of Mineral Surveys 336 and 593 is very poor. I declare this corner lost, and reestablish it by utilizing a bearing-bearing intersection, as follows. I determined the mean bearing of the northeasterly end line of Columbia No. 2 to be N.51°37'56"W. I hold this same bearing for the southwesterly end line, measuring from Corner No. 7 of Columbia No. 2 to intersect the line between found accepted monuments at Corner No.'s 1 and 2 of the Climax Quartz Claim, M.S. 336.

FILED September 24, 2025
BAKER COUNTY SURVEYOR
SURVEY NO. 8-37-242

RECORD OF LAND CORNER MONUMENTATION

CORNER #6 COLUMBIA NO. 2 QUARTZ CLAIM, MINERAL SURVEY 593,
SITUATED IN SECTION 32, T. 8 S., R. 37 E., W.M.
PAGE 2 OF 2

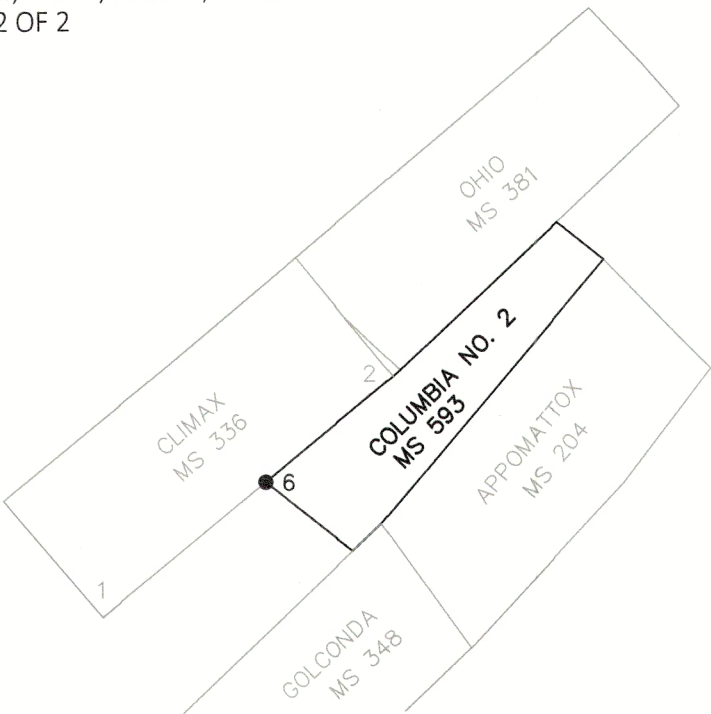


DESCRIPTION OF MONUMENTS AND ACCESSORIES SET AND METHODS USED: At the corner point, as determined by survey, I set a standard USFS 2 1/2" x 30" aluminum pipe with attached 3 1/4" aluminum cap, 24" in the ground. Raised a 3 ft. diameter mound of stone and earth around the monument to top of cap. Cap is marked as shown below.

From which, **I SCRIBE NEW BEARING TREES:**

- ▶ A lodgepole pine 13" dbh, bears S.55°E., 31.06 ft. marked X in upper blaze, and BT in lower blaze. This tree also has an old National Forest Boundary sign attached on the NE side, which has been partially over-grown by the tree.
- ▶ A lodgepole pine 11" dbh, bears S.06°13'W., 45.34 ft. marked COL2 - 6 MS 593 in upper blaze, and XBT in lower blaze.

CORNER MONUMENT MARKED:

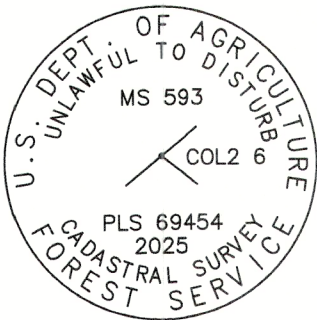

Placed a plastic-encased magnet at the base of the aluminum pipe. Painted a 6 inch red band around each bearing tree, and also painted the blazes red, and attached USFS 54-3 and 54-9 signs. Distances measured with a steel tape to a Mag Spike driven in the side-center-right at the root crown of each tree, with an attached 1 1/2" aluminum washer stamped PLS 69454. Used RTK GPS to measure bearings. Bearings are geodetic, based on GPS observation taken at the corner. Set an aluminum guard post S.52°E., 3.4 ft., with USFS 54-2 sign attached, and another aluminum guard post S.51°W., 2.2 ft., with USFS 54-2 and 54-9 signs attached. See associated Map of Survey dated August 20, 2025 for survey-related information.

RESTORATION BY, STAMP AND DATE:

Work performed June 11, 2025
Survey completed August 20, 2025

Jason L. Hatfield, PLS

USDA FOREST SERVICE
NORTHEAST OREGON LAND ZONE
1550 Dewey Avenue, Suite A
Baker City, OR 97814
(541) 523-1283

FILED September 24, 2025
BAKER COUNTY SURVEYOR
SURVEY NO. 8-37-242

REGISTERED
PROFESSIONAL
LAND SURVEYOR


OREGON
NOVEMBER 30, 2007
JASON L. HATFIELD
#69454
EXPIRES: 6/30/2027