

RECORD OF LAND CORNER MONUMENTATION

CORNER #7 COLUMBIA NO. 2 QUARTZ CLAIM, MINERAL SURVEY 593,
SITUATED IN SECTION 32, T. 8 S., R. 37 E., W.M.
PAGE 1 OF 2


ORIGINALLY ESTABLISHED BY: Charles M. Foster, U.S. Deputy Mineral Surveyor

MINERAL SURVEY NUMBER: 593

COMPLETION DATE: September 6, 1904

SUBSEQUENT SURVEYS:

- ▶ G.L.O. Retracement by Lincoln E. Wilkes, U.S. Cadastral Engineer, under Group No. 107, Approved May 26, 1927
- ▶ Corner search notes by John R. Mitchell, an unlicensed Survey Technician, as documented on U.S. Forest Service corner card dated 9/5/1969
- ▶ Unrecorded remonumentation by John R. Mitchell, an unlicensed Survey Technician, as documented on U.S. Forest Service corner card dated 6/10/1981
- ▶ Survey by Leland Myers, PLS #699, map filed December 22, 2003, as Survey No. 8-37-135 in the Baker County Surveyor's office

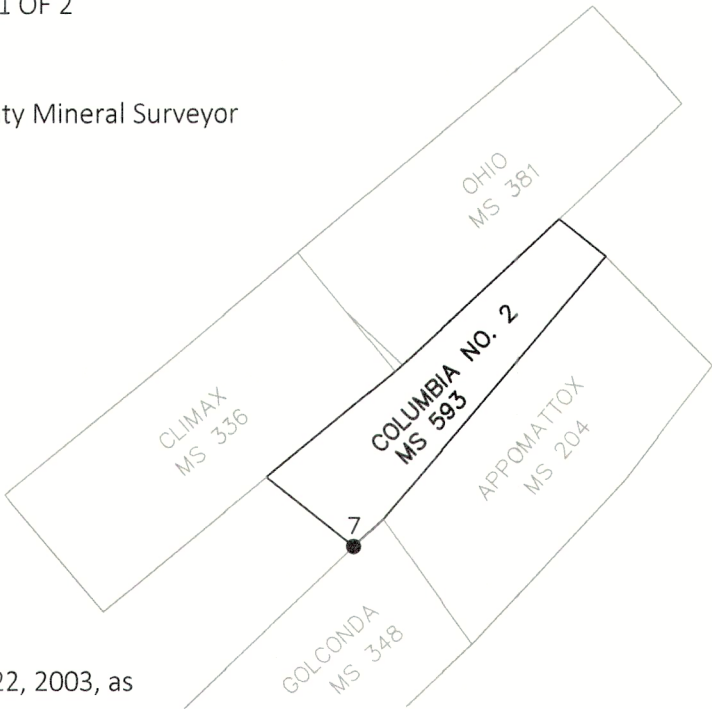

ORIGINAL DESCRIPTION: To Cor. No. 7 A tamarack post 4 ft. long 4 ins. square, set 18 ins. in the ground, surrounded with a mound of earth & scribed Col. No. 2-7-593 from which A pine 2 ft in diam. bears S75°20'E 7.4 ft. dist. marked Col. No. 2-7-593-B.T.

G.L.O. DESCRIPTION: To Cor. No. 7, Columbia No. 2, Claim, Sur. No. 593.

MITCHELL'S 1969 DESCRIPTION:

DESCRIBE CORNER MONUMENT FOUND

Post, 4x4, in mound of rock, 16" above grnd. in poor condition marked with scribing

DESCRIBE BEARING TREES OR OTHER OFFICIAL ACCESSORIES FOUND

36" pine stump with evidence of scribing brs. N.75°E 7.4 ft.

DESCRIBE CORNER LOCATION RELATIVE TO NEAR-BY FEATURES, ALSO HOW TO REACH CORNER

I am sure of this cor., but to have further proof I run on N.50°E. 142 ft. to Cor. #3 M.S. 348.

MITCHELL'S 1981 DESCRIPTION:

DESCRIBE CORNER MONUMENT FOUND

Rotting post in md of stone & earth

DESCRIBE BEARING TREES OR OTHER OFFICIAL ACCESSORIES FOUND

32" P.P. stump w/scribing brs N75°E 72'

MONUMENT: DESCRIBE NEW MONUMENT SET, OR WORK DONE TO PRESERVE EXISTING MONUMENT

2 1/2" BC on 1" X 32" gal. pipe set 25" deep in original hole & md of E & S marked COL2 MS 593 JRM 1981 & angle


MYERS' 2003 DESCRIPTION:

The map indicates that Myers found and accepted a monument (presumably Mitchell's) for the corner.

FILED September 24, 2025
BAKER COUNTY SURVEYOR
SURVEY NO. 8-37-243

RECORD OF LAND CORNER MONUMENTATION

CORNER #7 COLUMBIA NO. 2 QUARTZ CLAIM, MINERAL SURVEY 593,
SITUATED IN SECTION 32, T. 8 S., R. 37 E., W.M.
PAGE 2 OF 2

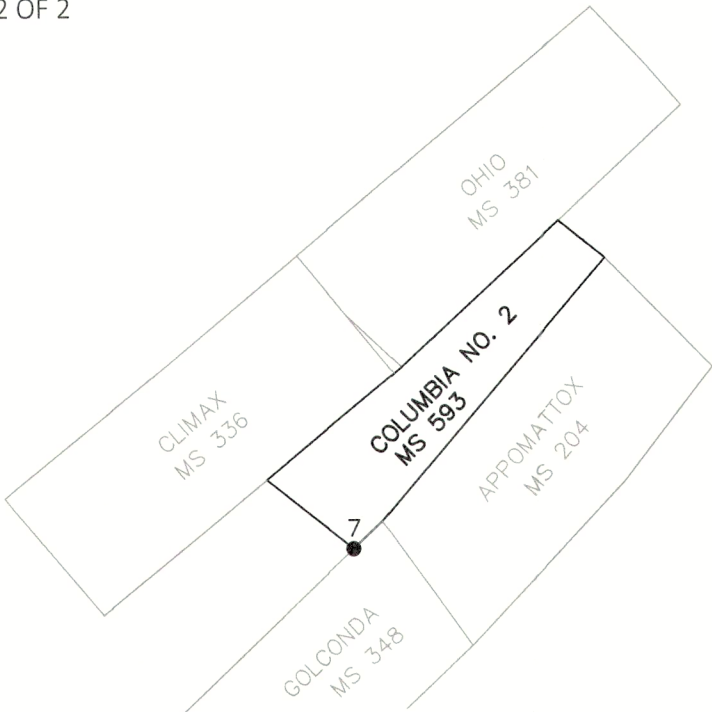


EVIDENCE FOUND: Found Mitchell's unrecorded monument, which is a 1 1/2" galvanized iron pipe with a 2 1/2" brass cap, marked as shown, projecting 8" above ground in a 3 ft. diameter mound of stone. From which,

- ▶ A white fir, 9" dbh, bears N.32°E., 9.3 ft. with fully-healed single blaze (Mitchell BT)
- ▶ Remains of ponderosa pine stump, bears N.75°E., 7.4 ft. with slab alongside containing partial blaze and scribing 7-593 BT (Original BT)
- ▶ A white fir, 8" dbh, bears N.61°W., 9.2 ft. with fully-healed single blaze (Mitchell BT)

DESCRIPTION OF MONUMENTS AND ACCESSORIES SET AND METHODS USED:

I accept Mitchell's brass cap monument as a faithful and accurate perpetuation of the original corner, being harmoniously related to other known corners in the area. It should be noted that in Mitchell's 1981 description, his measured bearing and distance to the original bearing tree stump is written as N.75°E., 72 ft., but I believe he omitted the decimal point and it should have been 7.2 ft.



CORNER MONUMENT MARKED:

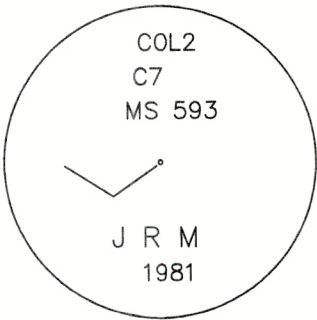

Painted a 6 inch red band around the bearing tree and also painted the blazes red, and attached new USFS 54-3 and 54-9 signs. Distances measured with a steel tape to a Mag Spike driven in the side-center-right at the root crown of each tree, with an attached 1 1/2" aluminum washer stamped PLS 69454. Used RTK GPS to measure accessories. Bearings are geodetic, based on GPS observation taken at the corner. Set an aluminum guard post N.50°W, 3 ft. with USFS 54-9 sign attached. See associated Map of Survey dated August 20, 2025 for survey-related information.

RESTORATION BY, STAMP AND DATE:

Work performed October 15, 2024
Survey completed August 20, 2025

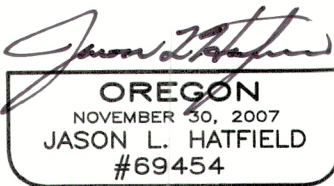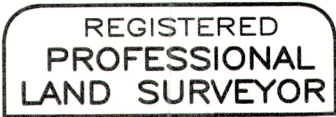

EXPIRES: 6/30/2027

USDA FOREST SERVICE
NORTHEAST OREGON LAND ZONE
1550 Dewey Avenue, Suite A
Baker City, OR 97814
(541) 523-1283

FILED September 24, 2
BAKER COUNTY SURVEYOR
SURVEY NO. 8-37-248