

RECORD OF LAND CORNER MONUMENTATION

NORTH QUARTER CORNER SECTION 30, T. 8 S., R. 37 E., W.M.

ORIGINALLY ESTABLISHED BY: Lincoln E. Wilkes, U.S. Cadastral Engineer

GROUP NUMBER: 107

APPROVAL DATE: May 26, 1927

SUBSEQUENT SURVEYS: Corner maintenance activities performed May 29, 1985 by William L. Hanley, PLS #1639, as evidenced by the Certified Record of Land Corner Monumentation filed February 5, 1986, as Baker County Survey No. 8-37-68

19		19	20
30	●	30	29
30		30	29
31		31	32

ORIGINAL DESCRIPTION: Set an iron post, 3 ft. long, 1 ins dia., 27 ins. in the ground, for $\frac{1}{4}$ sec. cor., with brass cap marked (diagram shown) from which

A black pine, 10 ins. dia., bears N. $40\frac{1}{2}^\circ$ E., 172 lks. dist., marked 1/4 S 19 BT.

A black pine, 15 ins. dia., bears S. $26\frac{1}{2}^\circ$ E., 123 lks. dist., marked 1/4 S 30 BT.

HANLEY'S DESCRIPTION: A brass cap of record dimensions and markings as shown in corner diagram.

A lodgepole pine log bears S $26\frac{1}{2}^\circ$ E, 123 lks. with healed blaze and roots in ground.

A dead lodgepole pine 15 ins dia bears N $40\frac{1}{2}^\circ$ E, 172 lks with scribes 1/4S19BT visible.

Improved surrounding rock mound around corner monument and set a 6 foot steel fence post alongside with a sign 54-9 attached.

New bearing trees established:

A lodgepole 11 ins dia bears N 51° W, 17.4 ft marked 1/4S19BT.

A lodgepole 11 ins dia bears S 14° W, 44.2 ft marked 1/4S30BT.

EVIDENCE FOUND: Found 1" iron pipe with 2 $\frac{1}{2}$ " brass cap, marked as shown below, projecting 10" above ground in a 2.5 ft. diameter collar of stone, with a steel fence post with USFS sign 54-9, located 4 ft. westerly and alongside.

From which, the following bearing trees were found:

- ▶ A lodgepole pine, 17" dbh, bears S. 14° W., 44.2 ft., with healed single blaze (Hanley BT) in good condition.
- ▶ A lodgepole pine, 18" dbh, bears N. 51° W., 17.4 ft., with healed single blaze (Hanley BT) in good condition.


DESCRIPTION OF MONUMENTS AND ACCESSORIES SET AND METHODS USED:

I accept the position of the found monument for the corner.

CORNER MONUMENT MARKED:

From which, **I SCRIBE NEW BEARING TREES:**

- ▶ A lodgepole pine, 10" dbh, bears N. 69° E., 36.57 ft. marked 1/4S19BT.
- ▶ A lodgepole pine, 14" dbh, bears S. 47° E., 68.15 ft. marked 1/4S30BT.

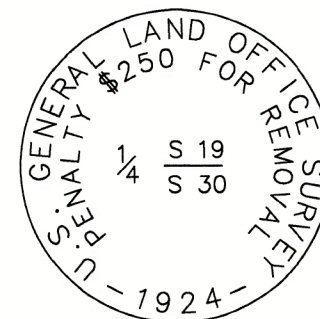

Painted a 6 inch red band around the bearing trees, and also painted the blazes red. Attached USFS 54-3 and 54-9 signs to BT's. Used a hand compass with 14° East declination to measure bearings. Used an EDM device to measure distances. Distances to new bearing trees were measured to a 60d nail driven in the side-center-right at the root crown of the tree, with an attached $1\frac{1}{2}$ " aluminum washer stamped PLS 69454. See associated Map of Survey dated October 17, 2023 for survey-related information.


RESTORATION BY, STAMP AND DATE:

Work Performed June 27, 2023 and Survey Completed October 17, 2023

Toribio J. Quinones, LSIT
Vincent L. Kelly, Survey Tech

USDA FOREST SERVICE
NORTHEAST OREGON LAND ZONE
1550 Dewey Avenue, Suite A
Baker City, OR 97814
(541) 523-1283

FILED December 20, 2023
BAKER COUNTY SURVEYOR
SURVEY NO. 8-37-142

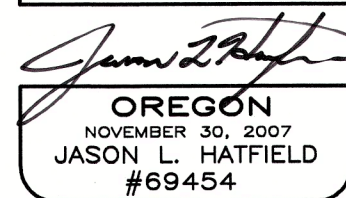

EXPIRES: 6/30/2025