

RECORD OF LAND CORNER MONUMENTATION

CENTER 1/4 CORNER SECTION 30, T. 8 S., R. 37 E., W.M.

ORIGINALLY ESTABLISHED BY: CORNER NOT PREVIOUSLY ESTABLISHED

GROUP NUMBER: N/A

APPROVAL DATE: N/A

19			19		20
30			30		29
		●			
30			30		29
31			31		32

ORIGINAL DESCRIPTION: N/A

EVIDENCE FOUND: N/A

DESCRIPTION OF MONUMENTS AND ACCESSORIES SET AND METHODS USED:

At the corner point as determined by survey, I set a standard USFS 2 1/2" x 30" aluminum pipe with attached 3 1/4" aluminum cap, 28" in the ground. Raised a 3 ft. diameter mound of stone around the monument to top of cap. Cap is marked as shown below.


From which, I SCRIBE A NEW BEARING TREE:

- ▶ An Engelmann spruce, 26" dbh, bears N.51°E., 29.80 ft. marked C1/4 S30 in upper blaze, and BT in lower blaze.

Also from which, I SET NEW REFERENCE POINTS:

- ▶ A 5/8"x 24" iron pin, bears S.53°22'E., 11.04 ft., with attached 2" aluminum cap marked RP 1 2023 PLS 69454
- ▶ A 5/8"x 24" iron pin, bears S.46°29'W., 40.93 ft., with attached 2" aluminum cap marked RP 2 2023 PLS 69454
- ▶ A 5/8"x 24" iron pin, bears N.44°11'W., 39.75 ft., with attached 2" aluminum cap marked RP 3 2023 PLS 69454

CORNER MONUMENT
MARKED:

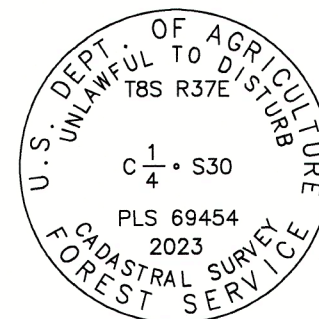


Placed a plastic-encased magnet beneath the base of the pipe. Painted a 6 inch red band around the bearing tree, painted the blazes red, and attached USFS 54-3 and 54-9 signs. Used RTK GPS to measure bearings to accessories. Bearings are geodetic, based on GPS observation at the corner. Used a steel tape to measure the distance to the bearing tree, measuring to a 60d nail driven in the side-center-right at the root crown of the tree, with an attached 1 1/2" aluminum washer stamped PLS 69454. Set and aluminum guard post North, with USFS 54-2 sign attached, and another East, with USFS 54-2 and 54-9 signs attached. See associated Map of Survey dated October 17, 2023 for survey-related information.

RESTORATION BY, STAMP AND DATE:

Work performed August 16, 2023
Survey completed October 17, 2023

Jason L. Hatfield, PLS
Daniel B. Lee, Survey Tech

USDA FOREST SERVICE
NORTHEAST OREGON LAND ZONE
1550 Dewey Avenue, Suite A
Baker City, OR 97814
(541) 523-1283

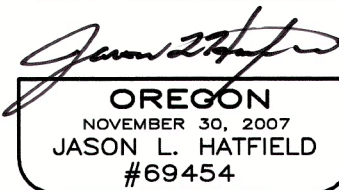

EXPIRES: 6/30/2025

FILED December 20, 2023

BAKER COUNTY SURVEYOR

SURVEY NO. 8-37-147