

RECORD OF LAND CORNER MONUMENTATION


EAST 1/4 CORNER SECTION 30, T. 8 S., R. 37 E., W.M.

ORIGINALLY ESTABLISHED BY: Lincoln E. Wilkes, U.S. Cadastral Engineer

GROUP NUMBER: 107

APPROVAL DATE: May 26, 1927

SUBSEQUENT SURVEYS: Corner maintenance activities performed May 29, 1985 by William L. Hanley, PLS #1639, as evidenced by the Certified Record of Land Corner Monumentation filed February 5, 1986, as Baker County Survey No. 8-37-74

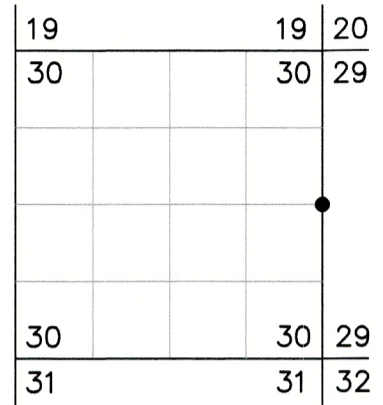

ORIGINAL DESCRIPTION: Set an iron post, 3 ft. long, 1 in. dia., 27 ins. in the ground, for 1/4 sec. cor., with brass cap marked (diagram shown) from which
 A balsam, 20 ins. dia., bears S. 60 1/2° E., 60 lks. dist., marked 1/4 S 29 BT.
 A balsam, 5 ins. dia., bears N. 88° W., 21 lks. dist., marked 1/4 S 30 BT.

HANLEY'S DESCRIPTION: A Brass cap of record dimensions and markings as shown in corner diagram.
 A dead alpine fir 27 in dia bears S60 1/2° E, 60 lks with scribes visible.
 No evidence of other BT.


Improved surrounding rock mound around recovered corner monument and set a 6 foot steel fence post alongside with a sign 54-9 attached.
 New bearing trees established:
 A lodgepole pine 10 ins dia bears N30°W, 23.4 ft marked 1/4S30BT.
 An alpine fir 11 ins dia bears N83°E, 12.5 ft marked 1/4S29BT.

EVIDENCE FOUND: Found 1" iron pipe with 2 1/2" brass cap, marked as shown below, projecting 5" above ground in a 2 ft. diameter mound of stone, with a steel fence post with attached USFS 54-9 sign set Northwest, 3 ft. from the found monument.
 From which:
 ▶ A subalpine fir, 15" dbh, bears N.83°E., 12.5 ft., with visible scribing in a partially healed blaze (Hanley BT).
 ▶ A lodgepole pine snag, bears N.30°W., 23.4 ft. (Hanley BT).
 All other bearing trees are dead and down.

DESCRIPTION OF MONUMENTS AND ACCESSORIES SET AND METHODS USED:

I accept the position of the found monument for the corner.
 From which, **I SCRIBE NEW BEARING TREES:**
 ▶ A subalpine fir, 8" dbh, bears S.39°E., 66.33 ft. marked 1/4S29BT in a single blaze.
 ▶ A subalpine fir, 12" dbh, bears S.34°W., 18.67 ft. marked 1/4S30BT in a single blaze.
 ▶ A subalpine fir, 19" dbh, bears N.74°W., 15.23 ft. marked 1/4S30BT in a single blaze.
 Painted a 6 inch red band around each bearing tree, and also painted the blazes red. Attached USFS 54-3 and 54-9 signs to BT's. Used a magnetic compass with 14° East declination to measure bearings to accessories. Used an EDM device to measure distances to new bearing trees, measuring to a 60d nail driven in the side-center-right at the root crown of the tree, with an attached 1 1/2" aluminum washer stamped PLS 69454. See associated Map of Survey dated October 17, 2023 for survey-related information.

CORNER MONUMENT MARKED:

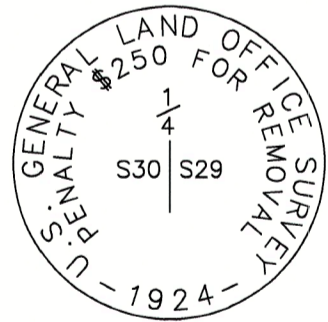


RESTORATION BY, STAMP AND DATE:

Work performed June 27, 2023
 Survey completed October 17, 2023

Toribio J. Quinones, LSIT
 Vincent L. Kelly, Survey Tech

USDA FOREST SERVICE
 NORTHEAST OREGON LAND ZONE
 1550 Dewey Avenue, Suite A
 Baker City, OR 97814
 (541) 523-1283

FILED December 20, 2023
 BAKER COUNTY SURVEYOR
 SURVEY NO. 8-37-149

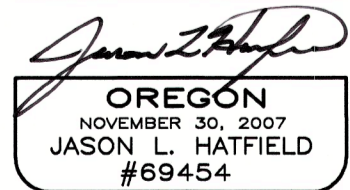

EXPIRES: 6/30/2025