

RECORD OF LAND CORNER MONUMENTATION

SOUTHEAST CORNER SECTION 30, T. 8 S., R. 37 E., W.M.

ORIGINALLY ESTABLISHED BY: Lincoln E. Wilkes, U.S. Cadastral Engineer

GROUP NUMBER: 107

APPROVAL DATE: May 26, 1927

SUBSEQUENT SURVEYS: Corner maintenance activities performed May 28, 1985 by William L. Hanley, PLS #1639, as evidenced by the Certified Record of Land Corner Monumentation filed February 5, 1986, as Baker County Survey No. 8-37-78

19			19	20
30			30	29
30			30	29
31			31	32

ORIGINAL DESCRIPTION: Set an iron post, 3 ft. long, 2 ins dia., 27 ins. in the ground, for cor. of secs. 29, 30, 31, and 32, with brass cap marked (diagram shown) from which
 A black pine, 6 ins. dia., bears N. 27° E., 30 lks. dist., marked T 8 S R 37 E S 29 BT.
 A white fir, 10 ins. dia., bears S. 33° E., 34 lks. dist., marked T 8 S R 37 E S 32 BT.
 A black pine, 7 ins. dia., bears S. 55° W., 35 lks. dist., marked T 8 S R 37 E S 31 BT.
 A black pine, 8 ins. dia., bears N. 35° W., 27 lks. dist., marked T 8 S R 37 E S 30 BT.

HANLEY'S DESCRIPTION: A brass cap of record dimensions and markings as shown in corner diagram.
 A dead pine, 11 ins dia, bears N56°E, 12.3 ft dist with scribes T8SR37ES29BT (record states N27°E, 30 lks)
 A dead pine, 8 ins diam, bears S52°E, 13.2 ft dist with partially healed blaze (record stated S33°E, 34 lks)
 A dead pine, 13 ins diam, bears N13°W, 26.4 ft dist with unreadable chopped scribes (record states N35°W, 27 lks)
 A dead pine, 12 ins diam, bears S78°W, 30.9 ft dist with scribes T8SR37ES31BT (record states S55°W, 35 lks)
 Improved surrounding rock mound around recovered corner monument and set a 6 foot steel fence post alongside with a sign 54-9 attached.
 New bearing trees established:
 A white fir, 6 ins diam, bears S04°W, 4.5 ft dist marked T8ST37ES31BT.
 A white fir, 7 ins diam, bears S56°E, 8.4 ft dist marked T8SR37ES32BT.
 A lodgepole pine, 6 ins diam, bears N22°E, 16.5 ft dist marked T8SR37ES29BT.
 A lodgepole pine, 6 ins diam, bears N34°W, 20.2 ft dist marked T8SR37ES30BT.

EVIDENCE FOUND: Found 2" iron pipe with 2 1/2" brass cap, marked as shown below, projecting 10" above ground in a scattered mound of stone, with a steel fence post with attached USFS 54-9 sign, Southeast, 2.5 ft.

From which:

- ▶ A lodgepole pine, 7" dbh, bears N.22°E., 16.5 ft., with visible scribing in open double blazes (poor health)(Hanley BT).
- ▶ A white fir, 12" dbh, bears S.56°E., 8.4 ft., with healed double blazes (Hanley BT).
- ▶ A white fir stump, bears S.04°W., 4.5 ft. (Hanley BT).
- ▶ A lodgepole pine, 7" dbh, bears N.34°W., 20.2 ft., with visible scribing in open double blazes (poor health)(Hanley BT).

DESCRIPTION OF MONUMENTS AND ACCESSORIES SET AND METHODS USED:


I accept the position of the found monument for the corner. I rebuilt the mound of stone, 3 ft. diameter to base of cap.

From which, **I SCRIBE NEW BEARING TREES:**

- ▶ A lodgepole pine, 11" dbh, bears N.02°W., 23.95 ft. marked X in upper blaze, and BT in lower blaze.
- ▶ A grand fir, 14" dbh, bears S.32°W., 29.45 ft. marked T8SR37ES31 in upper blaze, and BT in lower blaze.

Painted a 6 inch red band around each bearing tree, painted the blazes red, and attached USFS 54-3 and 54-9 signs. Used a magnetic compass with 14° East declination to measure bearings. Used an EDM device to measure distances to new bearing trees, measuring to a 60d nail driven in the side-center-right at the root crown of each tree, with an attached 1 1/2" aluminum washer stamped PLS 69454.

CORNER MONUMENT
MARKED:

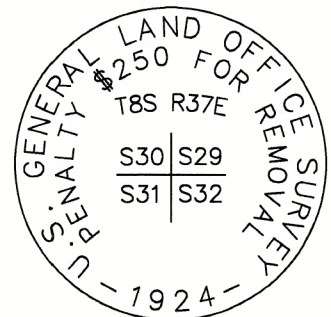


RESTORATION BY, STAMP AND DATE:

Work performed June 7, 2023
 Survey completed October 17, 2023

Jason L. Hatfield, PLS
 Daniel B. Lee, Survey Tech

USDA FOREST SERVICE
 NORTHEAST OREGON LAND ZONE
 1550 Dewey Avenue, Suite A
 Baker City, OR 97814
 (541) 523-1283

FILED December 20, 2023
 BAKER COUNTY SURVEYOR
 SURVEY NO. 8-37-158

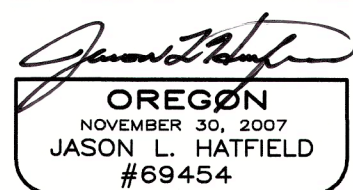

EXPIRES: 6/30/2025