

# RECORD OF LAND CORNER MONUMENTATION


SOUTH 1/4 CORNER SECTION 33, T. 8 S., R. 37 E., W.M.

**ORIGINALLY ESTABLISHED BY:** Lincoln E. Wilkes, U.S. Cadastral Engineer

**GROUP NUMBER:** 107

**APPROVAL DATE:** May 26, 1927

**SUBSEQUENT SURVEYS:** Corner maintenance activities performed October 17, 1984, by William L. Hanley, PLS #1639, as evidenced by the Certified Record of Land Corner Monumentation filed June 11, 1985, as Baker County Survey No. 8-37-12.

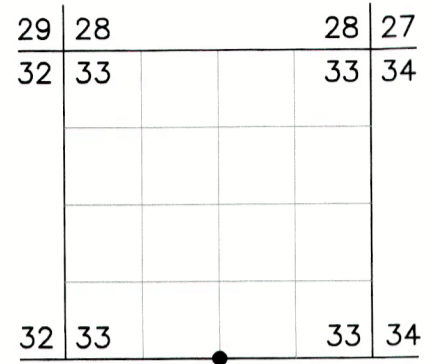

**ORIGINAL DESCRIPTION:** Set an iron post, 3 ft. long, 1 in. dia., 27 ins. in the ground, for 1/4 sec. cor. of sec. 33 only, with brass cap marked (diagram shown) from which  
 A white fir, 30 ins dia., bears N. 45° W., 407 lks. dist., marked 1/4 S33 BT.  
 A black pine, 8 ins dia., bears N. 12 3/4° W., 278 lks. dist., marked 1/4 S33 BT.

**HANLEY'S DESCRIPTION:** Original iron corner monument not found and presumed destroyed by logging activity. A fir 38 ins diam with healed blaze and a pine 20 ins diam with healed blaze for original accessories.

At position established from original accessory evidence set a aluminum cap on an aluminum pipe 30 inches long with 26 inches buried in the ground and 4 inches projecting out of the ground with a surrounding rock mound and a 6 foot steel fence post alongside with a sign 54-9 attached.  
 Aluminum cap marked thus: (diagram shown)

Each original bearing tree has a sign 54-3 attached above the BT blaze and has a sign 54-9 attached on the opposite side of the tree and has a 6 inch band of red paint around.

**EVIDENCE FOUND:** Found 2 1/2" aluminum pipe with 2 1/2" aluminum cap, marked as shown below, projecting 8" above ground, in a 2 ft. diameter mound of stone, with a steel fence post with attached USFS 54-9 sign set West, 4 ft. from monument.

From which,

- ▶ A lodgepole pine, 24" dbh, bears N.12 1/4°W., 183.48 ft., in good condition with a healed blaze (GLO BT).
- ▶ A white fir snag, 32" dbh, bears N.45°W., 268.62 ft. (GLO BT).


**DESCRIPTION OF MONUMENTS AND ACCESSORIES SET AND METHODS USED:**

I accept the position of the found monument for the corner.

CORNER MONUMENT MARKED:

From which, **I SCRIBE NEW BEARING TREES:**

- ▶ A western juniper, 8" dbh, bears N.51°E., 53.65 ft. marked *T8SR37E1/4S33BT* in single blaze.
- ▶ A western juniper, 12" dbh, bears S.68°E., 21.08 ft. marked X in upper blaze and BT in lower blaze.
- ▶ A western juniper, 19" dbh, bears S.55°W., 71.80 ft. marked X in upper blaze and BT in lower blaze.

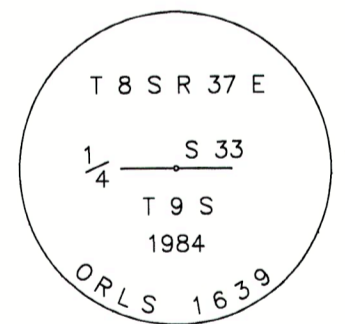

Painted a 6 inch red band around each bearing tree, painted the blazes red, and attached USFS 54-3 and 54-9 signs. Used a magnetic compass with 14° East declination to measure bearings to BT's. Used an EDM device to measure distances to new bearing trees, measuring to a 60d nail driven in the side-center-right at the root crown of the tree, with an attached 1 1/2" aluminum washer stamped PLS 69454.

**RESTORATION BY, STAMP AND DATE:**

Work Performed July 6, 2023  
 Survey completed October 17, 2023

Toribio J. Quinones, LSIT  
 Daniel B. Lee, Survey Tech

USDA FOREST SERVICE  
 NORTHEAST OREGON LAND ZONE  
 1550 Dewey Avenue, Suite A  
 Baker City, OR 97814  
 (541) 523-1283

FILED December 20, 2023  
 BAKER COUNTY SURVEYOR  
 SURVEY NO. 8-37-169  
9-37-344 A-11

