

CERTIFIED RECORD OF LAND CORNER MONUMENTATION

History of original corner establishment:

Corner established by John Hagel, U.S. Deputy Mineral Surveyor, under instructions received from the United States Surveyor General for Oregon dated Oct. 19, 1899, and designated as Survey No. 378.

Surveyor General records state:

Beginning at Cor. No. 1, a post previously described identical with the S.W. location Cor. identical with Cor. No. 6 Charleston Lode.

A tamarack tree, 15 ins. in diam., bears N82°45'W, 50.0 ft.
A tamarack tree, 10 ins. in diam., bears N47°40'W, 58.0 ft.
Both blazed and marked Tel. C. 1-378 BT.

Corner was perpetuated by: John Hagel, U.S. Deputy Mineral Surveyor, under instructions dated Nov. 28, 1900, and designated as Survey No. 378 Amended.

Record states:

Beginning at Cor. No. 1, identical with Cor. No. 1 of the original survey, a tamarack post 4 ins. square 4 1/2 ft. long, set 18 ins. in the ground with a mound of earth around it, marked TEL. C. 1-378.

A tamarack tree, 15 ins. in diam., bears N82°45'W, 50.0 ft.
A tamarack tree, 10 ins. in diam., bears N47°40'W, 58.0 ft.
both blazed and marked TEL. C. 1-378 BT.

Corner was remonumented by: John R. Mitchell, an unlicensed Forester, as described by USFS Corner Card.

Record states:

Piece of 4 x 4 post w/ scribing, in poor condition, marked 378.

30" (green) larch brs N82°45'W, 50 ft., scribing partially grown over.
12" (down) larch brs N47°40'W, 58 ft., with full scribing.

Corner was perpetuated by: Leland Myers, per Baker County Survey 8-37-135/9-37-279 in 2003. No Corner Record for this Monument was found. It is apparent Myers accepted the Mitchell brass cap and stamped his number and date over the top of Mitchell's.

Continued on page 2 of 2

REGISTERED
PROFESSIONAL
LAND SURVEYOR

Kristina Powell

OREGON
MAY 9, 2017
KRISTINA POWELL
91201

EXPIRES 12-31-24

FILED January 8, 2024
BAKER COUNTY SURVEYOR
SURVEY NO. 8-37-184

CERTIFIED RECORD OF LAND CORNER MONUMENTATION

Description of corner evidence found:

A 1 inch galv. iron pipe with a 2 1/2 inch brass cap, marked as shown. Firmly set 2 inches above ground, with 3 ft. diam. by 1 ft. tall stone mound.

From which:

A 22 inch tamarack (by Hagel) with visible scribing on mostly healed blaze, bears N82°45'W, 50.0 feet to 1 1/2 inch SS washer mkd: PLS 699 in left side center, alive & healthy.


Rotten tamarack remains (by Hagel) with scribe marks visible, bears N47°40'W, 58.0 feet.

A 2 1/2 inch brass cap mkd: CH 6, bears N28 1/2°W, 9.42 feet.

Monument falls West 640 feet from Fruit Creek Road; approximately 3,500 feet northerly of the intersection with NF-5540 Road.

T 8 S R 37 E
MS 378 AMD
1 TEL

TELEPHONE
Cor. 1

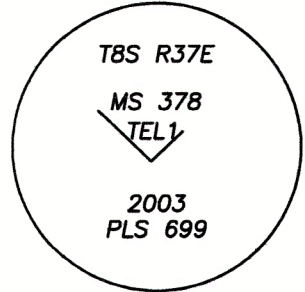

*2003 and PLS 699 were stamped over the top of the Mitchell stamping.

Description of monument and accessories I established to perpetuate original location of this corner:

New Bearing Tree:

An 8 inch lodgepole pine mkd: X BT on a single blaze, bears N5°W, 37.4 feet to a 3/4 inch brass tag mkd: PLS 91201 in right side center.

Added Bearing Tree and Land Survey Monument signs as needed.

NAD 83 Geodetic Position

Lat. 44°49'07.7" N
Long. 118°12'45.1" W

Established by: Garmin ETREX 32x

I hereby certify that the corner is monumented and accessories taken as described using a steel tape and a Warren Knight staff compass, set with a declination of 14° East.

Witnesses: David Quittschreiber, Justin Seal

September 21, 2023

REGISTERED
PROFESSIONAL
LAND SURVEYOR

Kristina Powell

OREGON
MAY 9, 2017
KRISTINA POWELL
91201

EXPIRES 12-31-24

FILED January 8, 2024
BAKER COUNTY SURVEYOR
SURVEY NO. 8-37-184