

CERTIFIED RECORD OF LAND CORNER MONUMENTATION

HISTORY OF ORIGINAL CORNER ESTABLISHED:

Corner established by Manius Buchanan in GLO Contract Number 635, dated April 19, 1895. Surveyor General field notes state:


A fir, 4 ins. diam., for 1/4 Sec. cor. marked 1/4 S. on W side, from which:
 A fir 27 ins. diam., bears N. 77° W., 65 lks. dist. marked 1/4 S BT.
 A fir 4 ins. diam., bears N. 78° E., 2 lks. dist. marked 1/4 S. BT.

Corner perpetuated by C. Albert White in BLM Dependent Resurvey, under Special Instructions dated May 3, 1957 and January 5, 1965 and included under Group Number 350 and 567 from found original BT's. Field notes state:

A fir, 42 ins. diam., bears N. 77° W., 65 lks. dist., with a healed blaze. Opened to reveal axe mks. and a partial scribing on a decayed face.

At the corner point, set an iron post, 28 ins. long, 2 1/2 ins. diam., 20 ins. in the ground, in a mound of stone, 3 ft. base, to top, with brass cap, from which a new bearing tree:
 A fir, 20 ins. diam., bears S. 81 1/2° E., 118 lks. dist., mkd. 1/4 S23 BT.

T 8 S R 38 E P-17

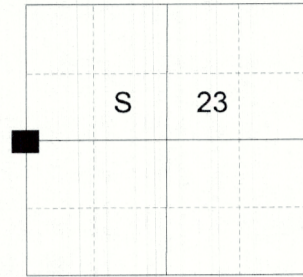

DESCRIPTION OF CORNER EVIDENCE FOUND:

Found 2 1/2" iron pipe with 3" brass cap, marked as shown below, 3" above ground, from which:

A 51" White Fir bears North 77° West, a distance of 42.9 feet, alive and vigorous with healed blaze.


DESCRIPTION OF MONUMENT AND ACCESSORIES I ESTABLISHED TO MONUMENT THE ORIGINAL LOCATION OF THIS CORNER:

From the iron pipe monument:

NEW BEARING OBJECTS:

A 9" White Fir bears North 57° East, a distance of 12.30 feet, marked 1/4 S23 BT.
 A 10" White Fir bears South 45° East, a distance of 23.55 feet, marked 1/4 S23 BT.
 An 8" White Fir bears South 58° West, a distance of 10.50 feet, marked 1/4 S22 BT.

I hereby certify that the corner was perpetuated on October 22, 2020.
 Witness: Kyle A. Tucker

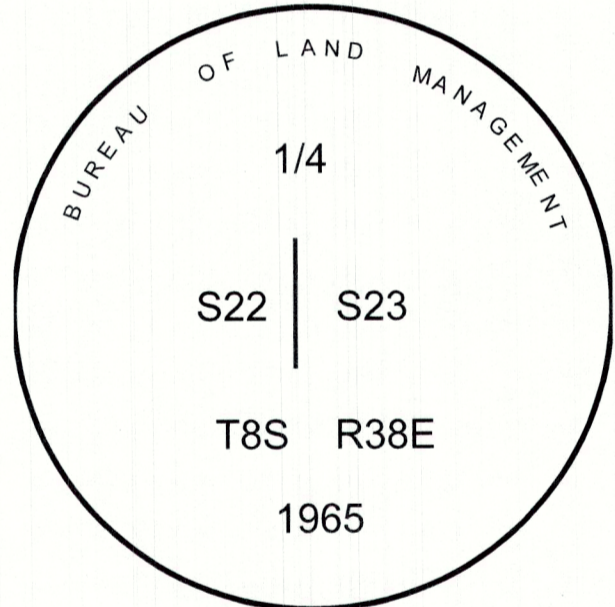

REGISTERED
 PROFESSIONAL
 LAND SURVEYOR



OREGON
 June 2, 2010
 JEFFREY S. HSU
 83571

Renewal Date: June 30, 2021

I used a steel tape and magnetic compass in the establishment of the new accessories. I used 14° East declination, the distances are to a 60d spike driven into the right side of the root crown of the bearing trees. A brass washer marked OPLS 83571 is attached to the BT blaze of the new bearing trees.

FILED November 18, 2020
 BAKER COUNTY SURVEYOR
 SURVEY NO. 8-38-147