


CERTIFIED RECORD OF LAND CORNER MONUMENTATION

HISTORY OF ORIGINAL CORNER ESTABLISHED:

Corner not previously established.

T 8 S R 38 E Q-18

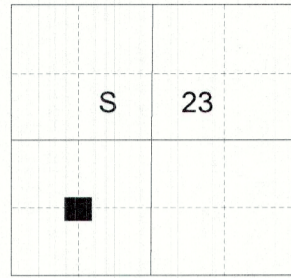

DESCRIPTION OF CORNER EVIDENCE FOUND:

None.

DESCRIPTION OF MONUMENT AND ACCESSORIES I ESTABLISHED TO MONUMENT THE ORIGINAL LOCATION OF THIS CORNER:


At position determined by survey, I set a 5/8" x 30" iron pin, 28" in the ground with 2 1/2" aluminum cap marked as shown, from which:

NEW BEARING OBJECTS:

A 10" Ponderosa Pine bears South 84° East, a distance of 12.60 feet, marked SW 1/16 S23 BT.
An 18" Ponderosa Pine bears South 64° West, a distance of 19.10 feet, marked SW 1/16 S23 BT.

Set a steel fencepost 1 ft. South of corner.

I hereby certify that the corner was monumented on November 5, 2020.
Witness: Kyle A. Tucker

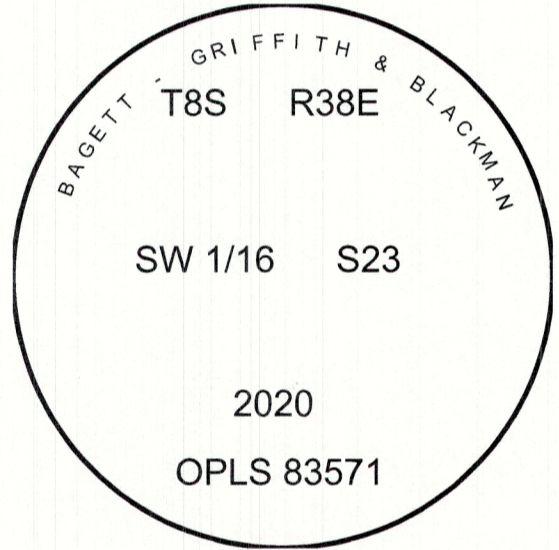

Renewal Date: June 30, 2021

I used a steel tape and magnetic compass in the establishment of the new accessories. I used 14° East declination, the distances are to a 60d spike driven into the right side of the root crown of the bearing trees. A brass washer marked OPLS 83571 is attached to the BT blaze of the new bearing trees.

FILED November 18, 2020
BAKER COUNTY SURVEYOR
SURVEY NO. 8-38-149