


CERTIFIED RECORD OF LAND CORNER MONUMENTATION

HISTORY OF ORIGINAL CORNER ESTABLISHED:

Corner not previously established.

T 8 S R 38 E S-17

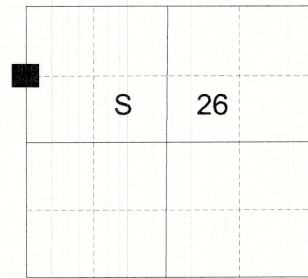

DESCRIPTION OF CORNER EVIDENCE FOUND:


None.

DESCRIPTION OF MONUMENT AND ACCESSORIES I ESTABLISHED TO MONUMENT THE ORIGINAL LOCATION OF THIS CORNER:

At position determined by survey, I set a 5/8" x 30" iron pin, 28" in the ground with 2 1/2" aluminum cap marked as shown, from which:

NEW BEARING OBJECTS:

An 11" Ponderosa Pine bears South 11° East, a distance of 5.95 feet, marked N1/16 S26 BT.
A 4" Douglas Fir bears North 33° West, a distance of 3.60 feet, marked N1/16 S27 BT.

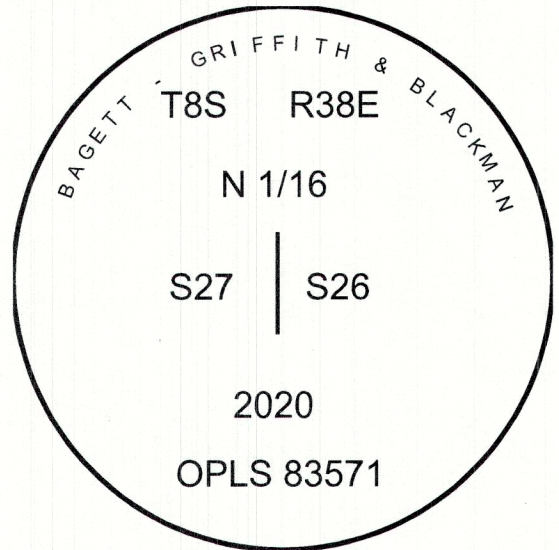

I hereby certify that the corner was monumented on November 4, 2020.

Witness: Kyle A. Tucker



Renewal Date: June 30, 2021

I used a steel tape and magnetic compass in the establishment of the new accessories. I used 14° East declination, the distances are to a 60d spike driven into the right side of the root crown of the bearing trees. A brass washer marked OPLS 83571 is attached to the BT blaze of the new bearing trees.

S-17

FILED November 18, 2020
BAKER COUNTY SURVEYOR
SURVEY NO. 8-38-151