


CERTIFIED RECORD OF LAND CORNER MONUMENTATION

HISTORY OF ORIGINAL CORNER ESTABLISHED:

Corner not previously established.


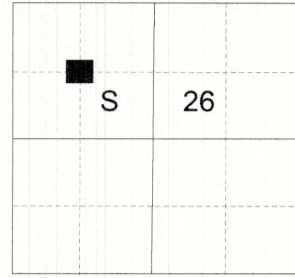

DESCRIPTION OF CORNER EVIDENCE FOUND:

None.

DESCRIPTION OF MONUMENT AND ACCESSORIES I ESTABLISHED TO MONUMENT THE ORIGINAL LOCATION OF THIS CORNER:


At position determined by survey, I set a 5/8" x 30" iron pin, 28" in the ground with 2 1/2" aluminum cap marked as shown, from which:

NEW BEARING OBJECTS:

A 6" Ponderosa Pine bears North 79° East, a distance of 9.70 feet, marked NW 1/16 S26 BT.
A 13" White Fir bears North 72° West, a distance of 30.80 feet, marked NW 1/16 S26 BT.

Set a steel fencepost 0.5 ft. West of corner.

I hereby certify that the corner was monumented on November 5, 2020.
Witness: Kyle A. Tucker

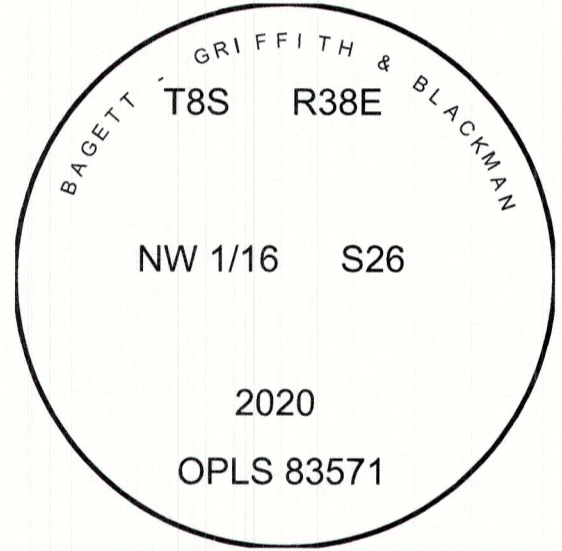

Renewal Date: June 30, 2021

I used a steel tape and magnetic compass in the establishment of the new accessories. I used 14° East declination, the distances are to a 60d spike driven into the right side of the root crown of the bearing trees. A brass washer marked OPLS 83571 is attached to the BT blaze of the new bearing trees.

FILED November 18, 2020
BAKER COUNTY SURVEYOR
SURVEY NO. 8-38-152