

CERTIFIED RECORD OF LAND CORNER MONUMENTATION

HISTORY OF ORIGINAL CORNER ESTABLISHED:


Corner established by C. Albert White in BLM Dependent Resurvey, under Special Instructions dated May 3, 1957 and January 5, 1965 and included under Group Number 350 and 567. Field notes state:

Set an iron post, 28 ins. long, 2 1/2 ins. diam., 22 ins. in the ground, with brass cap, from which:

A fir, 15 ins. diam., bears N. 76 1/4° W., 46 lks. dist. mkd. C E 1/16 S27 BT.

A fir, 7 ins. diam., bears S. 51 1/2° W., 20 lks. dist. mkd. C E 1/16 S27 BT.

T 8 S R 38 E T-16

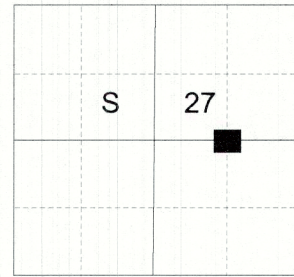

DESCRIPTION OF CORNER EVIDENCE FOUND:

Found 2 1/2" iron pipe with 3" brass cap, marked as shown below, 3" above ground, from which:

A 7" Fir, dead and downed, the root hole which bears South 52° West, a distance of 13.2 ft. with fragmentary scribe marks visible on decayed log. A 15" Fir stump, dead standing 4 ft. tall, bears North 76° West, a distance of 30.35 ft., with healed blaze on fallen top.

DESCRIPTION OF MONUMENT AND ACCESSORIES I ESTABLISHED TO MONUMENT THE ORIGINAL LOCATION OF THIS CORNER:

From the iron pipe monument:

NEW BEARING OBJECTS:


An 8" White Fir bears South 42° West, a distance of 16.70 feet, marked CE1/16 S27 BT.

A 5" White Fir bears North 36° West, a distance of 13.95 feet, marked CE 1/16 S27 BT.

Set a steel fencepost approx. 1 ft. South of corner

I hereby certify that the corner was perpetuated on November 2, 2020.

Witness: Kyle A. Tucker

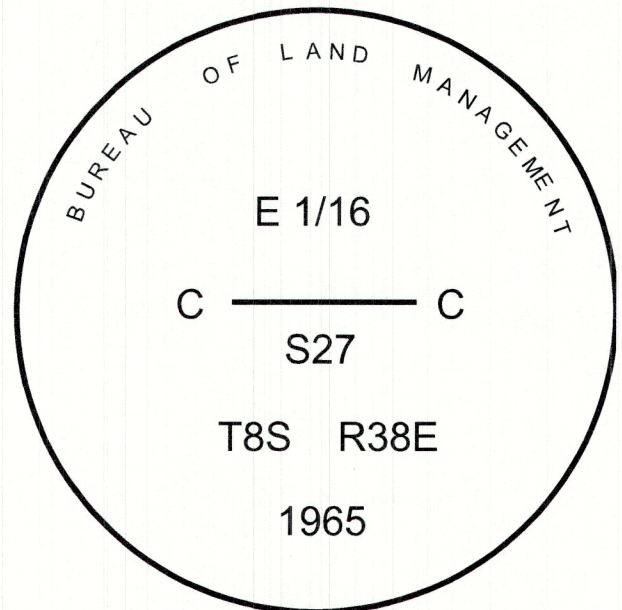

Renewal Date: June 30, 2021

I used a steel tape and magnetic compass in the establishment of the new accessories. I used 14° East declination, the distances are to a 60d spike driven into the right side of the root crown of the bearing trees. A brass washer marked OPLS 83571 is attached to the BT blaze of the new bearing trees.