

CERTIFIED RECORD OF LAND CORNER MONUMENTATION

HISTORY OF ORIGINAL CORNER ESTABLISHED:

Corner established by Manius Buchanan in GLO Contract Number 635, dated April 19, 1895. Surveyor General field notes state:


Set a post 3 ft. long, 3 ins. square, 24 ins. in the ground for 1/4 sec. cor. marked 1/4 S. on W. face, from which:

A black pine 8 ins. diam. bears S 76 1/2° W., 3 lks. dist. marked 1/4 S BT.
A tamarac 9 ins. diam., bears S 43 1/2° E., 16 lks. dist.

Corner perpetuated by C. Albert White in BLM Dependent Resurvey, under Special Instructions dated May 3, 1957 and January 5, 1965 and included under Group Number 350 and 567 from found original BT's. Field notes state:

At the corner point, set an iron post, 28 ins. long, 2 1/2 ins. diam., 24 ins. in the ground, with brass cap, from which new bearing trees:
A tamarack, 15 ins. diam., bears S. 39 1/4° E., 34 lks. dist. mkd. 1/4 S26 BT.
A fir, 13 ins. diam., bears N. 63° E., 47 lks. dist. mkd. 1/4 S27 BT.

T 8 S R 38 E T-17

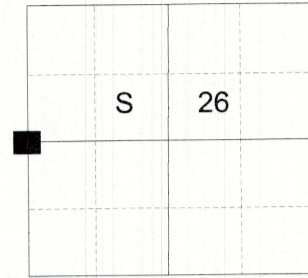

DESCRIPTION OF CORNER EVIDENCE FOUND:

Found 2 1/2" iron pipe with 3" brass cap, marked as shown below, 3" above ground, from which:

A 17" fir, dead standing ft. tall, bears North 63° West, a distance of 31.0 ft., with scribe marks visible on a partially healed blaze.
An 18" Tamarack bears South 39° East, a distance of 22.5 ft., alive and vigorous with healed blaze.

DESCRIPTION OF MONUMENT AND ACCESSORIES I ESTABLISHED TO MONUMENT THE ORIGINAL LOCATION OF THIS CORNER:


From the iron pipe monument:

NEW BEARING OBJECTS:

A 7" White Fir bears North 54° East, a distance of 43.30 feet, marked 1/4 S26 BT.
An 8" White Fir bears South 78° West, a distance of 31.95 feet, marked 1/4 S27 BT.
A 5" White Fir bears North 85° West, a distance of 14.90 feet, marked 1/4 S27 BT.

I hereby certify that the corner was perpetuated on November 2, 2020.

Witness: Kyle A. Tucker

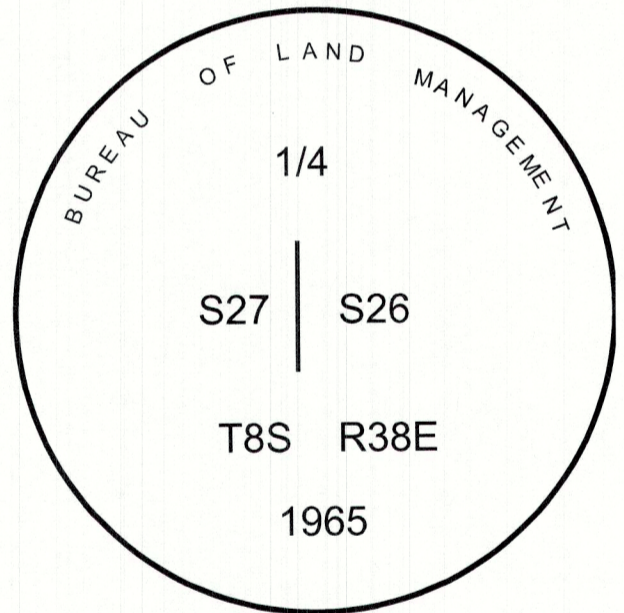

Renewal Date: June 30, 2021

I used a steel tape and magnetic compass in the establishment of the new accessories. I used 14° East declination, the distances are to a 60d spike driven into the right side of the root crown of the bearing trees. A brass washer marked OPLS 83571 is attached to the BT blaze of the new bearing trees.

T-17

FILED November 18, 2020
BAKER COUNTY SURVEYOR
SURVEY NO. 8-38-154