


CERTIFIED RECORD OF LAND CORNER MONUMENTATION

HISTORY OF ORIGINAL CORNER ESTABLISHED:

Corner established by Manius Buchanan in GLO Contract Number 635, dated April 19, 1895. Surveyor General field notes state:

T 8 S R 38 E V-13

Set a fir post 3 ft. long, 4 ins. square, 24 ins. in the ground for cor. to secs. 27, 28, 33 and 34, from which:

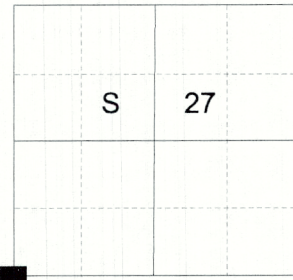

- A white fir 9 ins. diam. bears N54 1/2°E, 14 lks. dist., marked T8S R38E S27 BT.
- A white fir 7 ins. diam. bears S. 38 1/2° E, 22 lks. dist. marked T8S R38E S34BT.
- A white fir 8 ins. diam. bears S 53° W, 17 lks. dist. marked T8S R38E S33 BT.
- A white fir 7 ins. diam. bears N 65 1/2° W, 7 lks. dist. marked T8s R38E S28 BT.

Corner perpetuated by C. Albert White in BLM Dependent Resurvey, under Special Instructions dated May 3, 1957 and January 5, 1965 and included under Group Number 350 and 567 from found original BT's. Field notes state:

- A dead alpine fir, 10 ins. diam., bears N. 59° E., 14 lks. dist. mkd. T8S R38E S27 BT on an open blaze.
 - A dead and fallen alpine fir, 4 ins. diam., bears S. 35 1/2° E., 22 lks. dist. mkd. T8S R38E S34 BT on open blaze.
 - An alpine fir, 10 ins. diam., bears S. 50 1/2° W., 17 lks. dist. mkd. 3 and other illegible scribing on a nearly healed blaze.
 - A dead alpine fir, 8 ins. diam., bears N. 79° W., 7 lks. dist. mkd T8S R38E S27 BT on an open blaze.
- At the corner point, set an iron post, 28 ins. long, 2 1/2 ins. diam., 22 ins. in the ground, with brass cap, from which new bearing trees:
- A white pine, 10 ins. diam., bears N. 59° E., 19 lks. dist. mkd. T8S R38E S27 BT.
 - An alpine fir, 6 ins. diam., bears S. 19 1/2° E., 22 lks. dist. mkd. T8S R38E S34 BT.
 - A white pine, 8 ins. diam., bears N. 53° W., 16 lks. dist., mkd. T8s R38E S28 BT.

DESCRIPTION OF CORNER EVIDENCE FOUND:

Found 2 1/2" iron pipe with 3" brass cap, marked as shown below, 7" above ground, in mound of stone 1 ft. diam., from which:

A 16" Alpine Fir bears South 50° West, a distance of 11.2 ft., alive with healed blaze.
 A 10" White Pine bears North 53° West, a distance of 10.55 ft., alive and vigorous with scribe marks visible on partially healed blaze.

DESCRIPTION OF MONUMENT AND ACCESSORIES I ESTABLISHED TO MONUMENT THE ORIGINAL LOCATION OF THIS CORNER:


From the iron pipe monument:

NEW BEARING OBJECTS:

- A 7" Alpine Fir bears South 56° East, a distance of 10.80 feet, marked T8S R38E S34 BT.
- An 8" Alpine fir bears South 13° West, a distance of 14.75 feet, marked X BT.
- No vigorous trees available in NE quadrant.

Set a steel fencepost approx. 1 ft. North of corner

I hereby certify that the corner was perpetuated on October 29, 2020.
 Witness: Kyle A. Tucker

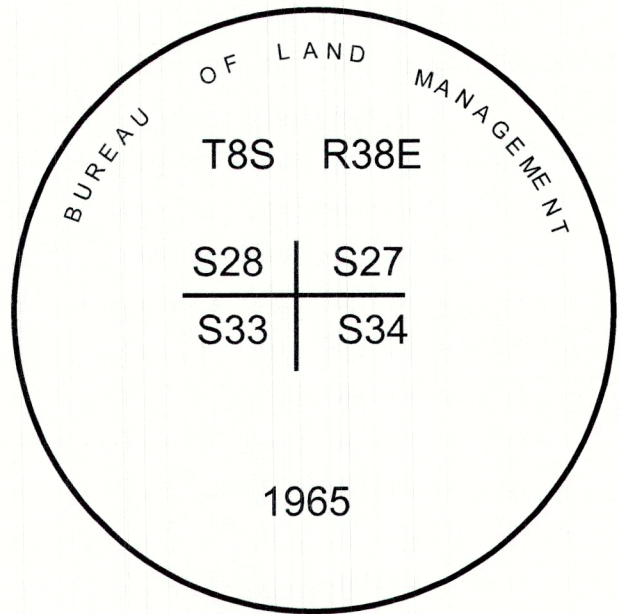

REGISTERED
 PROFESSIONAL
 LAND SURVEYOR



OREGON
 June 2, 2010
 JEFFREY S. HSU
 83571

Renewal Date: June 30, 2021

I used a steel tape and magnetic compass in the establishment of the new accessories. I used 14° East declination, the distances are to a 60d spike driven into the right side of the root crown of the bearing trees. A brass washer marked OPLS 83571 is attached to the BT blaze of the new bearing trees.

FILED November 18, 2020
 BAKER COUNTY SURVEYOR
 SURVEY NO. 8-38-155