

CERTIFIED RECORD OF LAND CORNER MONUMENTATION

HISTORY OF ORIGINAL CORNER ESTABLISHED:

Corner established by Manius Buchanan in GLO Contract Number 635, dated April 19, 1895. Surveyor General field notes state:


Set a fir post 3 ft. long, 4 ins. square, 24 ins. in the ground for 1/4 sec. cor. marked 1/4 S. on N face, from which:

A point of large rock bears N. 20 lks. dist. marked X 1/4
A mound of stone 3 1/2 ft. base 1 1/2 ft. high S. of cor.

Corner monumented by C. Albert White in BLM Dependent Resurvey, under Special Instructions dated May 3, 1957 and January 5, 1965 and included under Group Number 350 and 567 at proportionate position. Field notes state:

At the corner point, set an iron post, 28 ins. long, 2 1/2 ins. diam., 18 ins. in the ground, to bedrock, supported in a mound of stone, 4 ft. base, to top, with brass cap, from which:
A fir, 15 ins. diam., bears N. 83° W., 51 lks. dist. mkd. 1/4 S27 BT.
A fir 16 ins. diam., bears S. 46 1/2° W., 34 lks. dist. mkd 1/4 S34 BT.

T 8 S R 38 E V-15

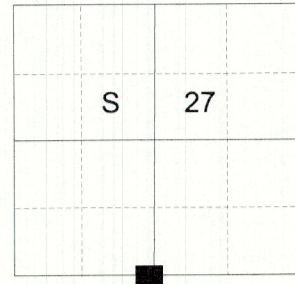

DESCRIPTION OF CORNER EVIDENCE FOUND:

Found 2 1/2" iron pipe with 3" brass cap, marked as shown below, 3" above ground, in mound of stone 4 ft. diam., from which:

A 24" Douglas Fir bears South 48° West, a distance of 22.50 feet, alive and vigorous with healed blaze.

A 25" Douglas Fir bears North 83° West, a distance of 33.50 feet, alive and vigorous with healed blaze.

DESCRIPTION OF MONUMENT AND ACCESSORIES I ESTABLISHED TO MONUMENT THE ORIGINAL LOCATION OF THIS CORNER:

From the iron pipe monument:

NEW BEARING OBJECTS:

A rock outcrop marked 'X BO', 4 ft. above monument on South facing cliff, bears North 56° East, a distance of 5.30 feet.


The top edge of a rock escarpment marked 'X BO' bears South 86° East, a distance of 7.35 feet.

I hereby certify that the corner was perpetuated on October 29, 2020.

Witness: Kyle A. Tucker



Renewal Date: June 30, 2021

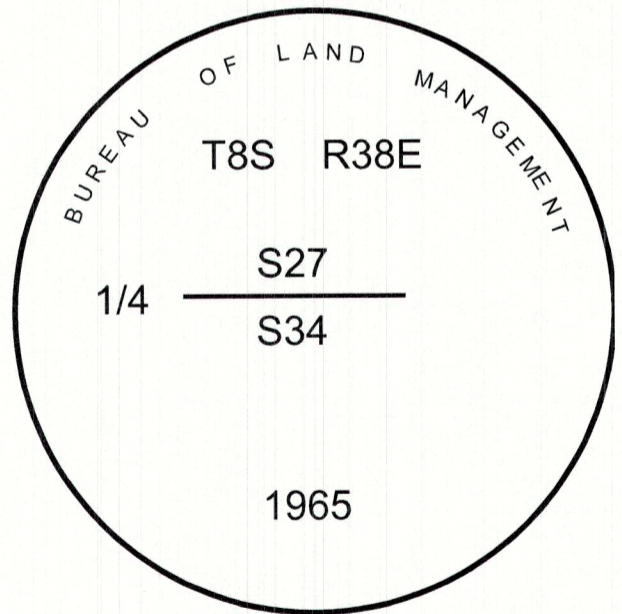

I used a steel tape and magnetic compass in the establishment of the new accessories. I used 14° East declination, the distances are to the center of the chiseled 'X'.

FILED November 18, 2020
BAKER COUNTY SURVEYOR
SURVEY NO. 8-38-156