

**CERTIFIED RECORD OF LAND CORNER MONUMENTATION**

**HISTORY OF ORIGINAL CORNER ESTABLISHED:**


Corner established by C. Albert White in BLM Dependent Resurvey, under Special Instructions dated May 3, 1957 and January 5, 1965 and included under Group Number 350 and 567. Surveyor General field notes state:

Set an iron post, 28 ins. long, 2 1/2 ins. diam., 24 ins. in the ground, with brass cap, from which:

A fir, 6 ins. diam., bears N. 61° W., 44 lks. dist., mkd. E 1/16 S27 BT.

A fir, 6 ins. diam., bears S. 21° E., 68 lks. dist. mkd. E 1/16 S34 BT.

T 8 S R 38 E V-16

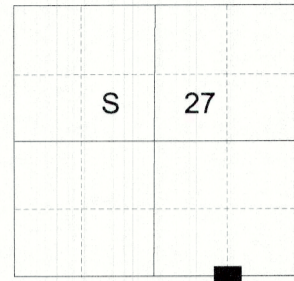

**DESCRIPTION OF CORNER EVIDENCE FOUND:**

Found 2 1/2" iron pipe with 3" brass cap, marked as shown below, 3" above ground, from which:

A 25" Douglas Fir bears South 21° East, a distance of 44.85 ft, alive and vigorous with healed blaze.

No remains of NW bearing tree.

**DESCRIPTION OF MONUMENT AND ACCESSORIES I ESTABLISHED TO MONUMENT THE ORIGINAL LOCATION OF THIS CORNER:**


From the iron pipe monument:

**NEW BEARING OBJECTS:**

A 7" White Fir bears North 30° West, a distance of 4.65 feet, marked E 1/16 S27 BT.

Set a steel fencepost approx. 1 ft. South of corner

I hereby certify that the corner was perpetuated on November 2, 2020.  
Witness: Kyle A. Tucker

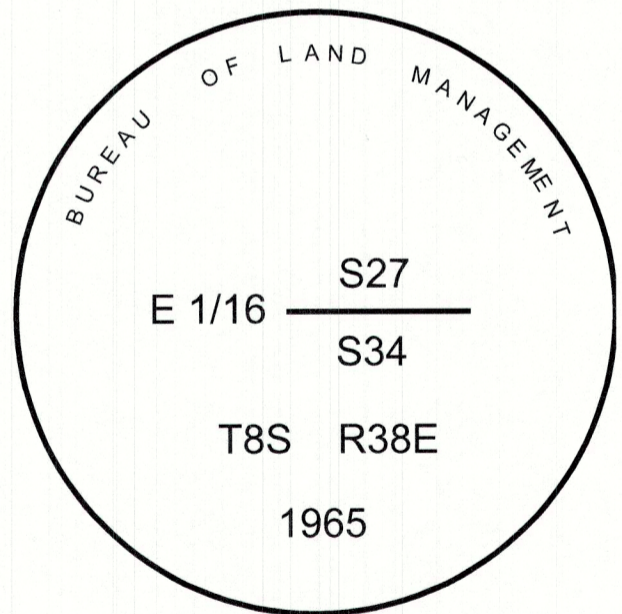

I used a steel tape and magnetic compass in the establishment of the new accessories. I used 14° East declination, the distances are to a 60d spike driven into the right side of the root crown of the bearing trees. A brass washer marked OPLS 83571 is attached to the BT blaze of the new bearing trees.



Renewal Date: June 30, 2021

FILED November 18, 2020  
BAKER COUNTY SURVEYOR  
SURVEY NO. 8-38-157