



BAKER COUNTY, OREGON
SEC. 24, T8S R39E

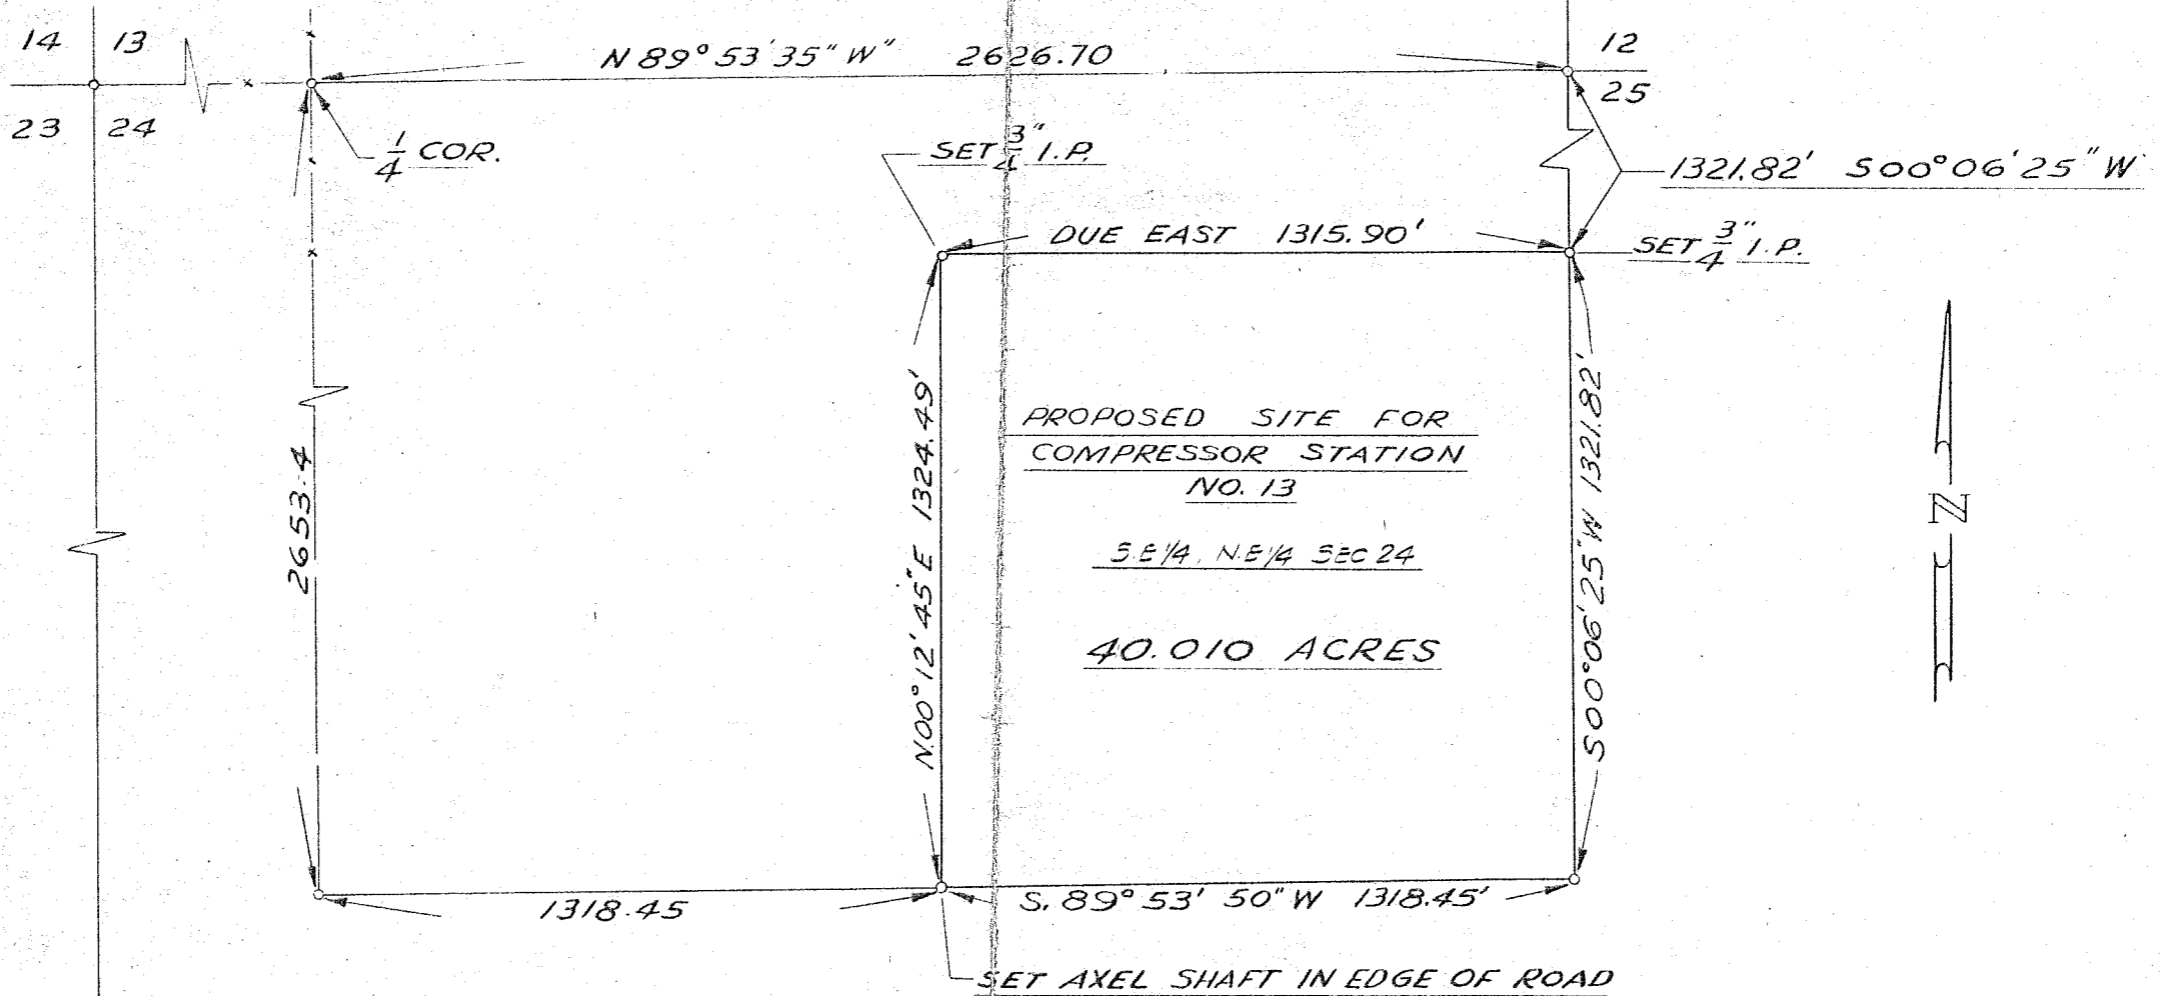

I, James D. Hanley, of Baker, Oregon, certify that I am the duly qualified and acting County Surveyor of Baker County, Oregon; that I have carefully examined the above plat and the field notes of the survey for the subdivision of Section 24, T8S, R. 39E., W.M., and that this survey complies with the statutes of this state, with reference to standard section subdivision, therefore it is approved.

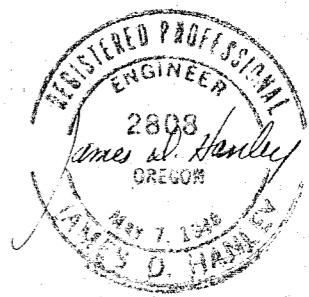

FILED Feb. 23, 1956
BAKER COUNTY SURVEYOR
SURVEY NO. 8-39-1

		SCALE 1" = 400'	FISH NORTHWEST CONSTRUCTORS, INC. HOUSTON, TEXAS ACTING AS AGENT FOR PACIFIC NORTHWEST PIPELINE CORP.	JOB NO. 10002
DR.	DATE	CH.		
OB	2-16-56	CNB	2-22-56	26-10-20
TR.		APPR.		
		PS Jr		
REVISION	BY	DATE	PROPOSED SITE FOR COMPRESSOR STATION NO. 13	