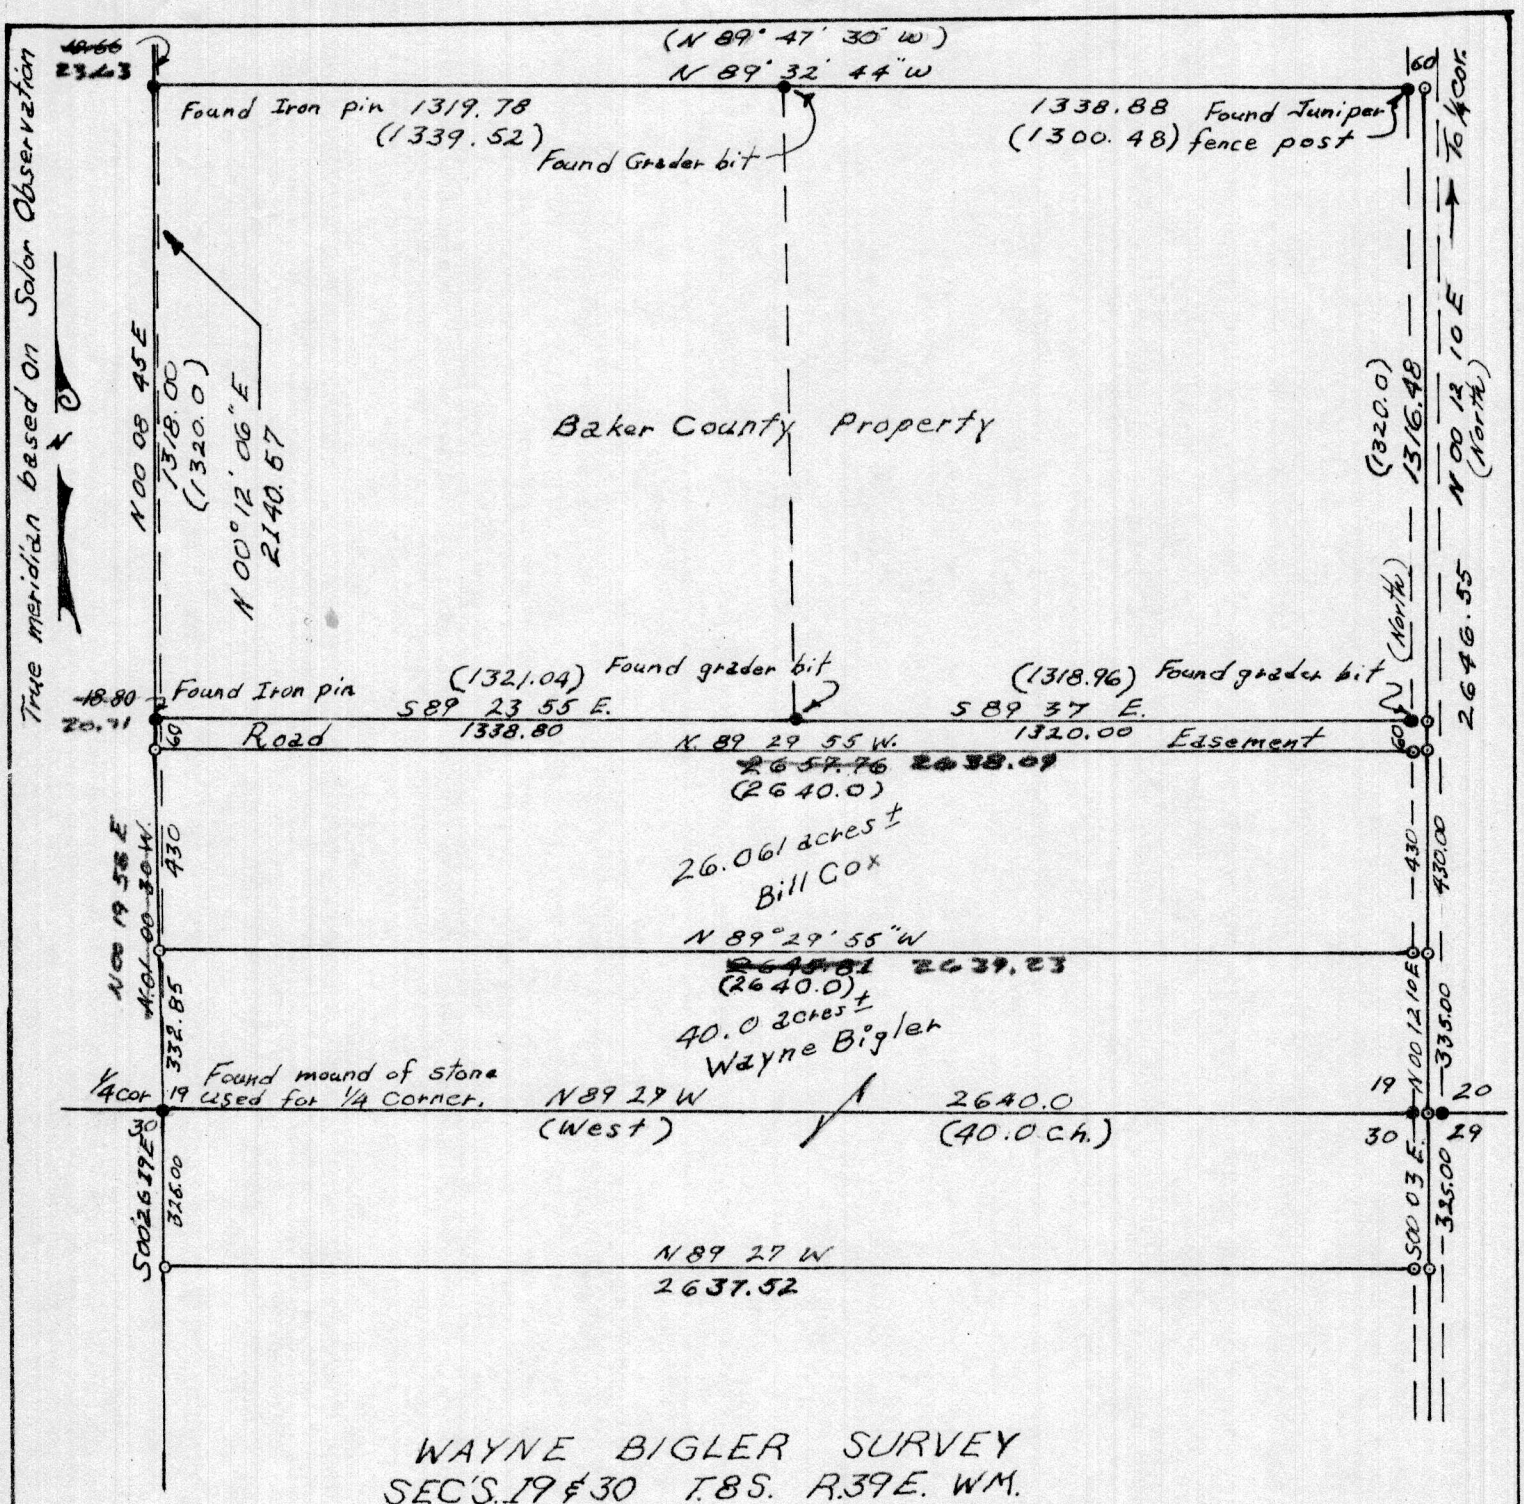

WAYNE BIGLER SURVEY
SEC'S. 19 & 30 T. 8S. R. 39 E. WM.
Scale 1" = 400' Date 4-30-71

NOTE: Since this survey was made a complete subdivision of section 19 has been made the adjustments shown here are as in the field and shown on the plat dated 12-17-71
T 8S R 39E Sec's 18 & 19

James H Hambleton
645 March 28, 1973
BAKER COUNTY SURVEYOR
SURVEY No. B 59-13

REGISTERED
OREGON
LAND SURVEYOR
James H Hambleton
JULY 10, 1964
JAMES H. HAMBLETON
645