


# CORNER RESTORATION

CORNER: NW SEC. 27 TWP. 8 S. RANGE 39 E.

ORIGINAL SURVEY BY: D.P Thompson & D. Chaplin

CONTRACT NUMBER: 104

CONTRACT DATE: April 16, 1864

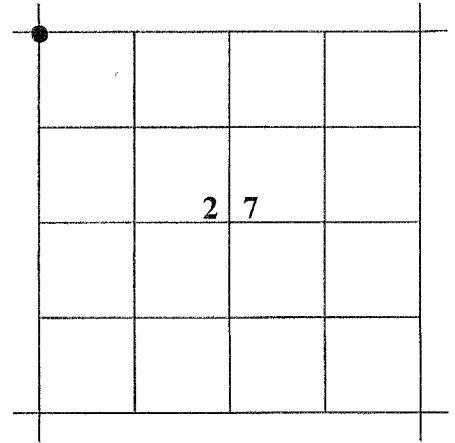

**ORIGINAL DESCRIPTION:** Set post for corner to secs 21, 22, 27 & 28 in mound of earth with charred stake, pits trenched as per instructions.

**RESTORATION BY, STAMP AND DATE:**

Michael C. Springer, PLS  
Jason L. Hatfield, PLS



May 22, 2009

**EVIDENCE FOUND:** After a diligent search, we found no original evidence at the corner location. I interviewed several land owners in the area regarding the existing fences near this corner. They stated that the fences had been in their current locations for many years. In addition, the fence corner fits harmoniously with the found monument at the N1/4 Corner of Section 27. I accept the fence corner as the best available evidence of the section corner.

**DESCRIPTION OF MONUMENTS AND ACCESSORIES SET AND METHODS USED:**

At the corner point: I set a 5/8"x30" iron pin, 30" in the ground, with attached 2" aluminum cap marked as shown

FROM WHICH I SET THE FOLLOWING NEW REFERENCE POINTS:


A 5/8"x30" iron pin, bears N00°47'30"W, 66.08 ft., with attached 1-1/2" aluminum cap marked "BMLS SURVEY MARKER RP1 2009" pin is in a N-S fence.

A 5/8"x30" iron pin, bears N88°34'00"E, 33.28 ft., with attached 1-1/2" aluminum cap marked "BMLS SURVEY MARKER RP2 2009" pin is in an E-W fence.

A 5/8"x30" iron pin, bears S01°56'30"W, 25.59 ft., with attached 1-1/2" aluminum cap marked "BMLS SURVEY MARKER RP3 2009" pin is in a N-S fence.

A 5/8"x30" iron pin, bears N88°00'30"W, 35.58 ft., with attached 1-1/2" aluminum cap marked "BMLS SURVEY MARKER RP4 2009" pin is in an E-W fence.

Used RTK GPS to measure to RP's. The bearings shown hereon are based on the record survey for Steve Feiling and Wayne Lewis filed in the office of the Baker County Surveyor.

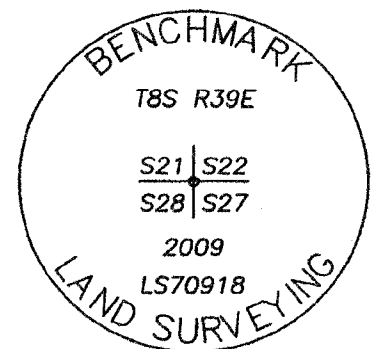

FILED June 25, 2009  
BAKER COUNTY SURVEYOR  
SURVEY NO. 8-39-26 107