

CERTIFIED RECORD OF LAND CORNER MONUMENTATION

**HISTORY OF ORIGINAL CORNER ESTABLISHED:**

Corner originally established by Timothy W. Davenport under GLO contract number 102 dated July 20, 1863. Surveyor General field notes state:

Set qr. sec post and made mound of rock

T7S R39E Z-23

S	36	

**DESCRIPTION OF CORNER EVIDENCE FOUND:**

Found a 3 ft. diam. collar of embedded stone. Due to harmony with adjacent corners, I accept this as the best available evidence of original GLO corner.

**DESCRIPTION OF MONUMENT AND ACCESSORIES I ESTABLISHED TO MONUMENT THE ORIGINAL LOCATION OF THIS CORNER:**


At position of the collar of stone, I set a 5/8"x30" iron pin, 29" in the ground, with 2 1/2" aluminum cap marked as shown below, in a collar of stone 3 ft. diam., from which:

**NEW BEARING OBJECTS:**

- A 5/8"x15" iron pin bears North 30°33' East, a distance of 20.78 feet with 1 1/4" aluminum cap marked BGB SURVEY MARKER NE RP.
- A 5/8"x15" iron pin bears South 67°51' East, a distance of 17.05 feet with 1 1/4" aluminum cap marked BGB SURVEY MARKER SE RP.
- A 5/8"x15" iron pin bears South 33°30' West, a distance of 20.67 feet with 1 1/4" aluminum cap marked BGB SURVEY MARKER SW RP.
- A 5/8"x15" iron pin bears North 54°36' West, a distance of 20.21 feet with 1 1/4" aluminum cap marked BGB SURVEY MARKER NW RP.


I hereby certify that the corner was monumented on October 28, 2019.

REGISTERED  
PROFESSIONAL  
LAND SURVEYOR



OREGON  
June 2, 2010  
JEFFREY S. HSU  
83571

Renewal Date: June 30, 2021

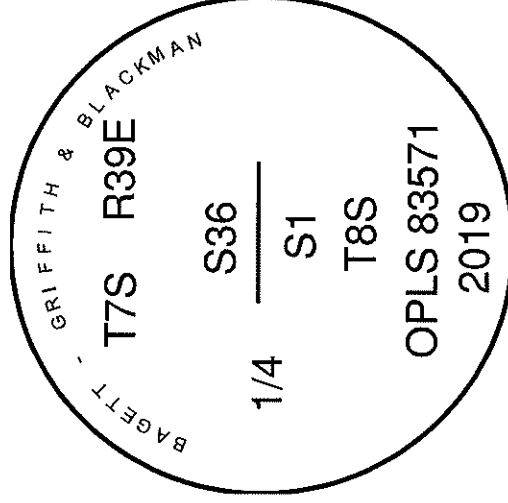

I used a Leica GS-18 RTK GPS in the establishment of the accessories. Bearings and distances are to the center of the aluminum caps. Basis of Bearings is as per Survey for McEst Ranches, as filed with the Baker County Surveyor.

Z-23

FILED Nov. 6, 2019  
BAKER COUNTY SURVEYOR  
SURVEY NO. 7-39-102  
8-39-127