


**CERTIFIED RECORD OF LAND CORNER MONUMENTATION**

**HISTORY OF ORIGINAL CORNER ESTABLISHMENT:**

THIS CORNER WAS ORIGINALLY ESTABLISHED BY DAVID P. THOMPSON AND DANIEL CHAPLIN UNDER CONTRACT NO. 104 DATED APRIL 16, 1864.

SURVEYOR GENERAL LAND OFFICE RECORDS STATE:  
 "SET POST FOR 1/4 SEC. CORNER IN MOUND OF EARTH WITH A CHARRED STAKE, PITS TRENCH 8' AS PER INSTRUCTIONS"

**DIAGRAM**

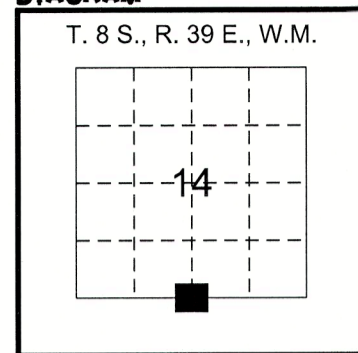

**DESCRIPTION OF CORNER EVIDENCE FOUND:**

HELD FENCE CORNER AS BEST REMAINING EVIDENCE OF CORNER LOCATION

**DESCRIPTION OF MONUMENT AND ACCESSORIES ESTABLISHED TO PERPETUATE THE ORIGINAL LOCATION OF THIS CORNER:**

RE-ESTABLISHED THE CORNER BY SINGLE PROPORTION BETWEEN THE FOUND SOUTHWEST AND SOUTHEAST CORNERS OF SECTION 14, T8S, R39E, WM.

SET 3-1/4" ALUMINUM CAP ON A 5/8" X 30" IRON ROD, FLUSH.


THE CAP IS MARKED AS SHOWN BELOW.

THE REFERENCES SET FOR SAID CORNER ARE AS FOLLOWS:

- 1) A 5/8" X 30" IRON ROD WITH A 1-1/2" ALUMINUM CAP, FLUSH, STAMPED "ODOT" BEARS S86°42'06"E, 31.12 FEET.
- 2) A 5/8" X 30" IRON ROD WITH A 1-1/2" ALUMINUM CAP, FLUSH, STAMPED "ODOT" BEARS N45°11'37"E, 47.20 FEET.
- 3) A 5/8" X 30" IRON ROD WITH A 1-1/2" ALUMINUM CAP, FLUSH, STAMPED "ODOT" BEARS N34°37'35"W, 34.23 FEET.
- 4) A 5/8" X 30" IRON ROD WITH A 1-1/2" ALUMINUM CAP, FLUSH, STAMPED "ODOT" BEARS S86°56'51"W, 36.58 FEET.

FILED *November 28, 2023*

BAKER COUNTY SURVEYOR  
 SURVEY NO. *839-156*

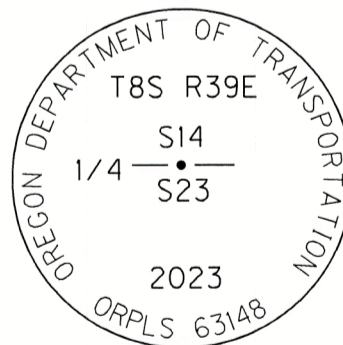

REGISTERED PROFESSIONAL LAND SURVEYOR

*BLC*

OREGON  
 JAN 14, 2003  
 BRET N. ELITHORP  
 61348

RENEWS: 12/31/2023

WITNESSES:  
 BRET ELITHORP, PLS  
 AARON COMSTOCK, LSIT

I HEREBY CERTIFY THAT THE ABOVE CORNER POSITION WAS RE-ESTABLISHED AS HEREON DESCRIBED ON NOVEMBER 14, 2023.

OREGON DEPARTMENT OF TRANSPORTATION  
  
**RIGHT OF WAY ENGINEERING**

Section	NORTH POWDER TO BAKER CITY		
Highway	LA GRANDE - BAKER HIGHWAY (US30)		
County	BAKER	Scale	NTS
Purpose	STOCK PILE	Date	NOV. 27, 2023