

**CERTIFIED RECORD OF LAND CORNER MONUMENTATION**

**DIAGRAM**

**History of original corner establishment:**


The original corner was set by Timothy W. Davenport, Deputy Surveyor, under Contract No. 102, dated July 20, 1863.

The original notes state:  
Set Qtr Sec post, made mound of Earth and drove charred stakes as per inst.

Baker County Survey No. 8-40-6 states:  
"Set PK nail at intersection of road right of way mid-point with West property line fence, in asphalt paving. No permanent monument found or set."

Baker County Survey No. 8-40-14 states:  
"PK Nail set by Ba. Co. Sur. No. 8-40-6 was not found. Set MAG nail this survey."

**T 8 S R 40 E**

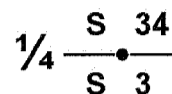

**T 9 S R 40 E**

**Description of corner evidence found:**

Found MAG nail set by Baker County Survey No. 8-40-14.

**Description of monument and accessories I established to perpetuate the original location of the corner:**

The corner was reestablished at the position of the said MAG nail. Set a 5/8" x 30" rebar with yellow plastic cap marked "HANLEY ENGR. PLS 1817", approximately 1" below asphalt surface.


**Corner monument references:**

From the corner monument:

A 5/8" x 30" rebar with yellow plastic cap marked "HANLEY ENGR. PLS 1817" set by Baker County Survey No. 8-40-14, bears N. 88° 33' 53" E., 30.00'.

A 5/8" x 30" rebar with yellow plastic cap marked "HANLEY ENGR. PLS 1817" set by Baker County Survey No. 8-40-14, bears N. 9° 56' 01" E., 149.78'.

Four MAG nail references were also set as shown in the diagram below.

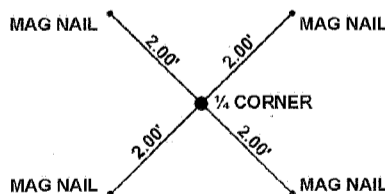

Reference surveys and basis of bearing: Baker County Survey No. 8-40-14.  
Baker County Partition Plat No. P2001-018.

I, Thomas J. Hanley certify that this corner was properly reestablished as witnessed by Eric Stricker and Kirby Danford on November 12, 2001.

FILED November 13, 2001  
BAKER COUNTY SURVEYOR  
SURVEY NO. 9-40-542 / 8-40-15  
CORNER PRES. NO. CP #63

**REGISTERED  
PROFESSIONAL  
LAND SURVEYOR**

*Thomas J. Hanley*

**OREGON**  
JULY 13, 1979  
**THOMAS J. HANLEY**  
1817

Renews June 30, 2003