

RECORD OF SURVEY

11187BALD.CRD / rac/tjl / 11187BALDpg1.dwg

THE UNITED STATES OF AMERICA  
BALDOCK SLOUGH LLC and  
KLEINFELDER WEST, INC.

in the  
NE 1/4 & SE 1/4 SEC. 9,  
NW, SW, & SE 1/4's SEC. 10  
NE 1/4 SEC. 15 and  
NE 1/4 SECTION 16  
T 8 S, R 40 E, W.M.  
BAKER COUNTY, OREGON

WRP EASEMENT No. 66-0436-9-9109

NOVEMBER 16, 2011


LEGEND

- .....FOUND 5/8" ROD WITH YELLOW PLASTIC CAP STAMPED "HANLEY ENGR LS 1817" PER SN 8-40-13 UNLESS OTHERWISE SHOWN.
- ⊙ .....FOUND 5/8" ROD WITH YELLOW PLASTIC CAP STAMPED "HANLEY ENGR LS 1817" PER SN 8-40-13 NOT ACCURATELY TIED FOR THIS SURVEY.
- ⊙ .....FOUND 5/8" ROD WITH 1-1/4" ALUMINUM CAP / SHRW
- ⊙ .....FOUND 5/8" ROD WITH YELLOW PLASTIC CAP STAMPED "PLS 699" PER SN 8-40-19.
- .....FOUND STEEL FENCE POST SET IN CONCRETE OCCUPYING TRUE CORNER POSITION PER SN 8-40-13
- .....SET 5/8" X 30" REBAR WITH A RED PLASTIC CAP STAMPED "NORTHSTAR SURVEYING".
- + .....COMPUTED POSITION, NOTHING FOUND OR SET BY THIS SURVEY
- .....EXISTING FENCE LINE

DATA OF, OR COMPUTED FROM, THE FOLLOWING:  
( )..SN 8-40-13 [ ]..SN 8-40-19

SN = BAKER COUNTY SURVEY NUMBER

ALL MONUMENTS, FOUND OR SET, NOW HAVE AN 84" GREEN STEEL POST AND SIGN.

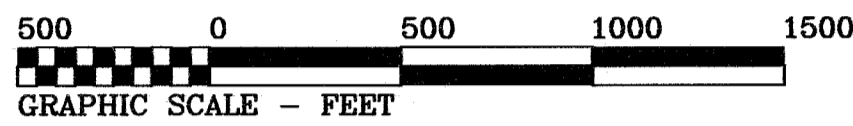

SEE NARRATIVE ON PAGE 2 OF 2

REGISTERED  
PROFESSIONAL  
LAND SURVEYOR

*Theodore James Langton*

OREGON  
JULY 13, 1979  
THEODORE JAMES LANGTON  
1823

RENEWS: 12/31/2012

NORTHSTAR SURVEYING, INC.

720 N.W. 4th Street  
Corvallis, Oregon 97330  
Phone: 541-757-9050

BALDOCK SLOUGH

WRP EASEMENT  
#66-0436-9-9109

764.08 ACRES

