


CERTIFIED RECORD OF LAND CORNER MONUMENTATION

HISTORY OF ORIGINAL CORNER ESTABLISHMENT:
Corner originally established by David P. Thompson and Daniel Chaplin under GLO Contract No. 104, dated April 16, 1864. Surveyor General record states:

Set post for corner to Sections 25, 26, 35 and 36 in mound of Earch with charred Stake. Pits trenched as per instructions.

In Survey 08-40-26, Jason Hatfield uses right-of-way fences and road deeds to place this corner, though he does not monument it.

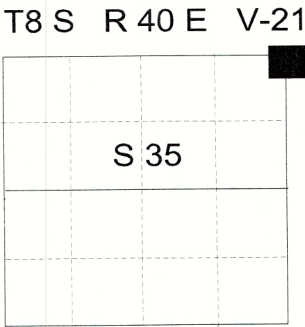

DESCRIPTION OF CORNER EVIDENCE FOUND:
None. Found a fence corner 37 feet to the South and 30 feet to the West of position described in Survey 08-40-26.

DESCRIPTION OF MONUMENT AND ACCESSORIES I ESTABLISHED
TO PERPETUATE THE ORIGINAL LOCATION OF THIS CORNER:


At position determined by retracement of Survey 08-40-26, I set a 5/8" x 30" iron pin, 34" in the ground, with 2" brass cap, marked as shown below, from which:

NEW BEARING OBJECTS:
A brass washer in a guy pole for a power line bears N37°13'43"E, a distance of 39.66 feet, marked OPLS 83571.

A 5/8" x 30" iron pin bears S37°00'13"E, a distance of 37.01 feet, with 1 1/2" aluminum cap marked BGB SURVEY MARKER SE RP.

A 5/8"x30" iron pin bears S37°03'52"W, 47.64 feet, with yellow plastic cap marked BGB SURVEY MARKER. Monument is for a property survey being conducted concurrently.

A 3" brass cap in concrete bears N43°28'10"W, a distance of 58.93 feet, marked DEPARTMENT OF THE INTERIOR GEOLOGICAL SURVEY 50RBR 1965.

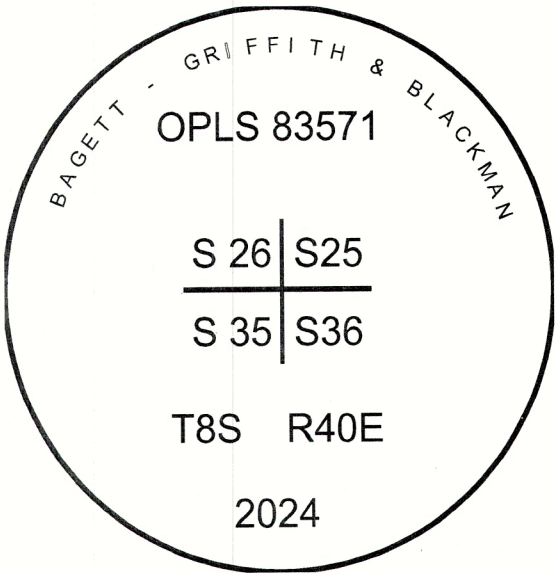

I hereby certify that the corner was perpetuated on May 17, 2024.

Corner falls at the intersection of Sunnyslope Road and South Airport Lane.

I used a Leica GS18 GPS in the establishment of the accessories. Basis of Bearing is Survey 08-40-26. Bearing and distance to the caps are to the center of the caps. Bearing and distance to the power pole is to a washer marked OPLS 83571 set in the base of the pole on the SW side.

REGISTERED
PROFESSIONAL
LAND SURVEYOR

OREGON
June 2, 2010
JEFFREY S. HSU
83571

Renewal Date: June 30, 2025

V-21

FILED May 22, 2024
BAKER COUNTY SURVEYOR
SURVEY NO. 8-40-51