


CERTIFIED RECORD OF LAND CORNER MONUMENTATION

History of original corner establishment:

Corner established by T. W. Davenport under GLO contract no. 102, dated July 20, 1863.

Surveyor General records state:

Set post corner to Secs 18, 19, 13 & 24, made mound of rocks.

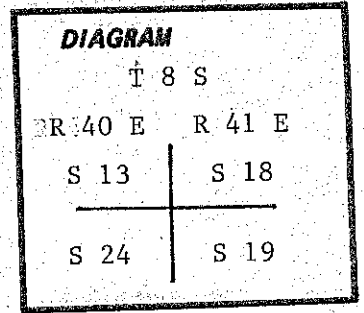

Description of corner evidence found:

Found mound of stone with old survey stake which is apparently the monument shown on OSHD drawing no. 6B-19-13 as "rock pile". The State highway department accepted this as the probable section corner. There is no evidence to say this rock mound is not the corner, or to declare the corner lost.


The highway tie to section corner one mile West is 5358.4 feet from this found rock mound and our measurement is 5359.0 feet to center of mound. Obviously the mound of stone has not been disturbed since highway tie of March, 1946.

I believe the proportionate measurement method of corner relocation would violate the laws regarding corner evidence and am hereby accepting the existing mound as the position of original corner position.

Description of monument and accessories established to perpetuate the original location of this corner:

Set a 2 1/2-inch brass cap on a 2-inch iron pipe 31-inches long, and projecting 8-inches out of the ground with a surrounding rock mound 3 feet in diameter.

Brass cap marked thus:

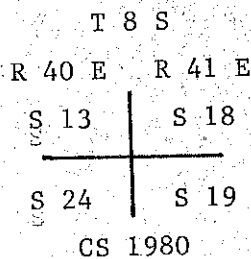

I hereby certify that the above described corner was properly remonumented under my supervision on April 28, 1980, and witnessed by Tom Fisk.



Office of..... County of.....
 State of....., I hereby certify that the within instrument was filed in this office
 for record on the..... day of....., 19.....
 by
 (COUNTY OFFICIAL) (DEPUTY)

Form R6-7100-57 (9/71)

FILED JAN 20, 1983
 BAKER COUNTY SURVEYOR
 SURVEY NO. 8-41-7
8-40-4