


CERTIFIED RECORD OF LAND CORNER MONUMENTATION

History of original corner establishment:

Corner established by T. W. Davenport under GLO contract no. 102 dated July 20, 1863.

Surveyor General records state:

Set qr. sec. post and made mound of earth and drove charred stake as per instructions.

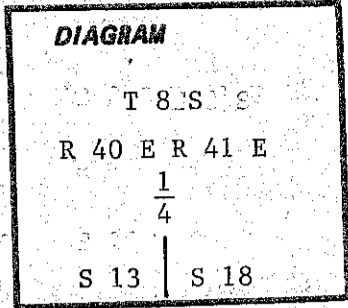


Description of corner evidence found:

Found mound of rocks, 2 feet in diameter.

Description of monument and accessories established to perpetuate the original location of this corner:

Set 2½ inch brass cap on 1 inch iron pipe 31 inches long and projecting 5 inches out of the ground in old rock mound.

Brass cap marked thus:

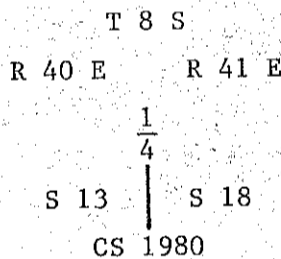

I hereby certify that the above described corner was properly remonumented under my supervision on April 28, 1980, and witnessed by Tom Fisk.

REGISTERED  
PROFESSIONAL  
LAND SURVEYOR

*James D. Hanley*  
OREGON  
SEPTEMBER 23, 1977  
JAMES D. HANLEY  
1206

Office of..... County of.....  
State of....., I hereby certify that the within instrument was filed in this office  
for record on the..... day of....., 19.....  
..... by .....  
(COUNTY OFFICIAL) (DEPUTY)

Form R6-7100-57 (9/71)

FILED Jan 20, 1983  
BAKER COUNTY SURVEYOR  
SURVEY NO. 8-41-8