


T.B.S. R. 41 E., W.M. N. 0° 05' 40" E., 5652.39'
 T.B.S. R. 42 E., W.M. 2627.15'

S. 89° 36' 34" E., 2569.33' (40.03)
 S. 89° 30' E., 2627.15'
 Used E-W fence line where intersects range line for section cor., not monumented this survey.

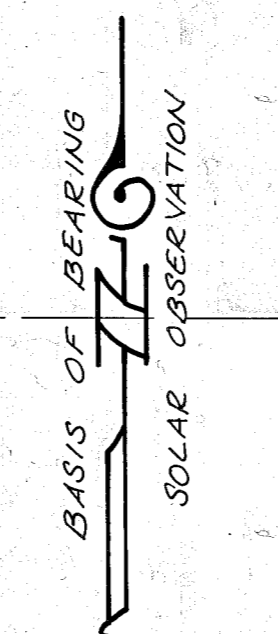

- LEGEND**
- ⊙ Evidence of original corner found, monumented as noted
 - Found corner evidence as perpetuated by fence line
 - Set 3/8" x 30" rebar w/ plastic cap mtd "HANLEY ENGRS. PL3 1206" SE 1/4 NE 1/4
 - Existing fence line
 - Property line bounding TL 3600 - TL 4604
 - () Original plat distance

MAP OF SURVEY
 LAND IN SECS. 17, 19, 20, 29, 30 AND 32
 T.B.S. R. 42 E., W.M. SHOWING DEEDED
 PROPERTY LINES vs. FENCED AREAS
 FOR FARM CREDIT SERVICES
 SEPT. - OCT., 1989 SCALE: 1" = 400'
 TL 4604 ADDED 11/2/89 SHEET 2 of 2

REGISTERED PROFESSIONAL LAND SURVEYOR
 James D. Hanley
 OREGON
 JAMES D. HANLEY
 1206

FILED Nov. 2 1989
 BAKER COUNTY SURVEYOR
 SURVEY NO. 3-42-3