

CERTIFIED RECORD OF LAND CORNER MONUMENTATION


R-11

History of original corner establishment:

This survey of the subdivisional lines of T. 8 S. R. 42 E. W.M., was performed by Deputy Surveyor John H. Stone under contract # 235, dated July 6, 1875.

GLO notes state:

Set stone 18 x 12 x 7 in. for 1/4 sec. cor.

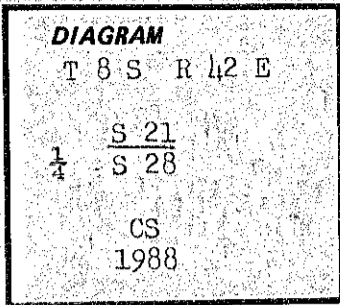


Description of corner evidence found:

Found basalt stone 12 x 9 x 7 ins. with a faint 1/4 chisled into it. The corner stone lined up well with a N-S fence line 1/4 mile to the North.

Description of monument and accessories established to perpetuate the original location of this corner:

At the position of the found corner stone: Set a 2 1/2 in. brass cap on a 1 in. dia., 30 in. long iron pipe, 26 ins. into the ground. Set a steel fence post 2 ft. South with a USPS 54-9 sign attached. Due to the lack of rocks no mound was constructed around the new monument. Buried the original corner stone 1.5 ft. North of the monument.

I certify that the above corner was perpetuated properly by standard survey methods as witnessed by Tom Fisk and Larry McBroom on October 24, 1988.

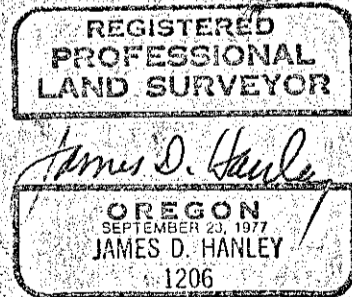

Office of..... County Surveyor..... County of..... Baker
OR
State of....., I hereby certify that the within instrument was filed in this office
for record on the..... day of....., 19.....
..... by

(COUNTY OFFICIAL)

(DEPUTY)

FILED Nov. 2 1989
BAKER COUNTY SURVEYOR
SURVEY NO. 8-42-5