


**CERTIFIED RECORD OF LAND CORNER MONUMENTATION**

**DIAGRAM**

**History of original corner establishment:**

The original corner was set by J.H. Stone, Deputy Surveyor, under Contract No. 235, dated July 6, 1875.

The original notes state:  
Set Post 4 feet long, 4 in. in dia. 1 foot in ground and raised mound and trench as per instructions for Cor to Secs 15, 16, 21, & 22.

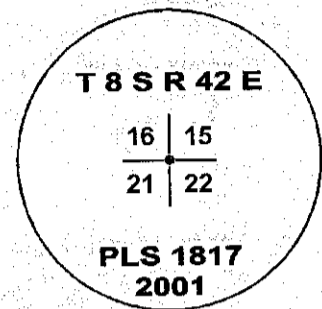

**Description of corner evidence found:**

An extensive search was made for the original post. No original corner evidence found. Accepted fence intersection as the corner to Sections 15, 16, 21, and 22. Fences run East, West, and North from the fence intersection.

**Description of monument and accessories I established to perpetuate the original location of the corner:**

Set a 2½" diameter brass cap on a 1" x 30" galvanized pipe. The cap is marked as shown in the corner diagram.

**Corner monument references:**

Four 1" x 2½" magnets encased in plastic were set 1' below the ground. From the corner monument:

- A silver magnet marked "1" bears N. 52° 38' E., 18.53'
- A pink magnet marked "2" bears S. 37° 06' E., 19.21'
- A blue magnet marked "3" bears S. 42° 44' W., 18.83'
- A orange magnet marked "4" bears N. 44° 03' W., 17.31'

Reference survey and basis of bearing: Baker County Survey No. 8-42-15.

I, Thomas J. Hanley certify that this corner was properly reestablished as witnessed by Kirby Danford and Asa Langrell on June 29, 2001.

FILED December 7, 2001  
BAKER COUNTY SURVEYOR  
SURVEY NO. 8-42-7  
CORNER PRES. NO. ~~CP #64~~ CP# 65

REGISTERED  
PROFESSIONAL  
LAND SURVEYOR

*Thomas J. Hanley*

OREGON  
JULY 13, 1979  
THOMAS J. HANLEY  
1817

Renews June 30, 2003