

Alpha-Num.
Index # N-15


CERTIFIED RECORD OF LAND CORNER MONUMENTATION

DIAGRAM

History of original corner establishment:

The original corner was set by J.H. Stone, Deputy Surveyor, under Contract No. 235, dated July 6, 1875.

The original notes state:
Set Post 4 feet long, 4 in. in dia. 1 foot in ground and raised mound and trench as per instructions for 1/4 Sec. Cor.

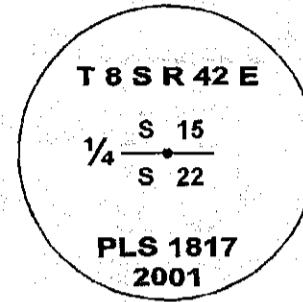

Description of corner evidence found:

An extensive search was made for the original post. No original corner evidence found.

Description of monument and accessories I established to perpetuate the original location of the corner:

The corner was reestablished in an East-West running fence line by single proportionate method between the Northwest and Northeast section corners of Section 22. Set a 2 1/2" diameter brass cap on a 1" x 30" galvanized pipe, 10" above ground, surrounded by a mound of stone. The cap is marked as shown in the corner diagram.

Corner monument references:

From the corner monument:

A 5/8" x 15" rebar with yellow plastic cap marked "HANLEY ENGR. PLS 1817" set approximately 0.1' below ground, bears N. 7° 47' 33" E., 9.00'.

A 5/8" x 15" rebar with yellow plastic cap marked "HANLEY ENGR. PLS 1817" set approximately 0.1' below ground, bears S. 88° 44' 34" E., 10.25'.

A 5/8" x 15" rebar with yellow plastic cap marked "HANLEY ENGR. PLS 1817" set approximately 1' below ground, bears S. 2° 09' 45" W., 10.21'.

A 5/8" x 15" rebar with yellow plastic cap marked "HANLEY ENGR. PLS 1817" set approximately 0.1' below ground, bears N. 87° 28' 09" W., 10.00'.

Reference survey and basis of bearing: Baker County Survey No. 8-42-15.

I, Thomas J. Hanley certify that this corner was properly reestablished as witnessed by Kirby Danford and Asa Langrell on July 3, 2001.

FILED December 7, 2001
BAKER COUNTY SURVEYOR
SURVEY NO. 8-42-8
CORNER PRES. NO. ~~CP #65~~ CP# 66

REGISTERED
PROFESSIONAL
LAND SURVEYOR

Thomas J. Hanley

OREGON
JULY 13, 1979
THOMAS J. HANLEY
1817

Renews June 30, 2003