


CERTIFIED RECORD OF LAND CORNER MONUMENTATION

DIAGRAM

History of original corner establishment:

The original corner was set by J.H. Stone, Deputy Surveyor, under Contract No. 235, dated July 6, 1875.

The original notes state:
Set Post 4 feet long, 4 in. in dia. 1 foot in ground, raised mound and trench as per instructions, for Cor. to Secs. 14, 15, 22, & 23.

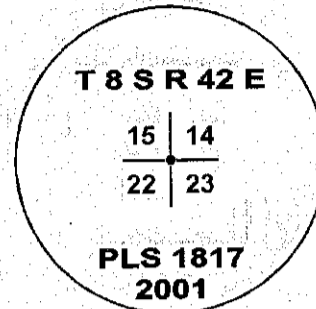

Description of corner evidence found:

An extensive search was made for the original post. No original corner evidence found. Found a drilled nail at fence intersection. Fences run South and West from fence intersection. See Narrative for Baker County Survey No. 8-42-15 for explanation of the origin of the drilled nail.

Description of monument and accessories I established to perpetuate the original location of the corner:

The corner was reestablished at position occupied by said drilled nail. Set a 2½" diameter brass cap on a 1" x 30" galvanized pipe. The cap is marked as shown in the corner diagram.

Corner monument references:

Four 1" x 2½" magnets encased in plastic were set 1' below the ground. From the corner monument:

- A silver magnet marked "1" bears N. 45° 26' E., 11.31'
- A pink magnet marked "2" bears S. 34° 09' E., 11.63'
- A blue magnet marked "3" bears S. 47° 23' W., 13.35'
- A orange magnet marked "4" bears N. 47° 14' W., 13.11'

Reference survey and basis of bearing: Baker County Survey No. 8-42-15.

I, Thomas J. Hanley certify that this corner was properly reestablished as witnessed by Kirby Danford and Asa Langrell on June 28, 2001.

FILED December 7, 2001
BAKER COUNTY SURVEYOR
SURVEY NO. 8-42-9
CORNER PRES. NO. ~~CP #66~~ CP# 67

**REGISTERED
PROFESSIONAL
LAND SURVEYOR**

Thomas J. Hanley

OREGON
JULY 13, 1979
THOMAS J. HANLEY
1817

Renews June 30, 2003