


CERTIFIED RECORD OF LAND CORNER MONUMENTATION

DIAGRAM

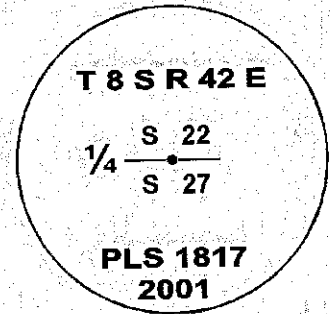

History of original corner establishment:

The original corner was set by J.H. Stone, Deputy Surveyor, under Contract No. 235, dated July 6, 1875.

The original notes state:
Set Post 4 feet long, 4 in. in dia. 1 foot in ground and raised mound and trench as per instructions for 1/4 Sec. Cor.

Description of corner evidence found:

An extensive search was made for the original post. No original corner evidence found.

Description of monument and accessories I established to perpetuate the original location of the corner:

The corner was reestablished at the position established by the Hubbs Dam Survey. The Hubbs Dam Survey established this corner at a fence intersection (fences ran East, West, and North from the intersection). A drilled nail was set at that position. Due to property line adjustments in the area the fence intersection no longer exists, only the East-West running fence remains. No trace of the drilled nail could be found. Set a 2 1/2" diameter brass cap on a 1" x 30" galvanized pipe at the position established by the said Hubbs Dam Survey. The cap is marked as shown in the corner diagram.

Corner monument references:

From the corner monument:

A 5/8" x 30" rebar with yellow plastic cap marked "HANLEY ENGR. PLS 1817" set approximately 8" below ground, bears N. 47° 55' 02" E., 10.39'.

A 5/8" x 30" rebar with yellow plastic cap marked "HANLEY ENGR. PLS 1817" set approximately 8" below ground, bears S. 67° 44' 13" E., 12.58'.

A 5/8" x 30" rebar with yellow plastic cap marked "HANLEY ENGR. PLS 1817" set approximately 8" below ground, bears S. 62° 20' 46" W., 11.80'.


A 5/8" x 30" rebar with yellow plastic cap marked "HANLEY ENGR. PLS 1817" set approximately 8" below ground, bears N. 43° 41' 50" W., 11.95'.

Reference survey and basis of bearing: Baker County Survey No. 8-42-15.

I, Thomas J. Hanley certify that this corner was properly reestablished as witnessed by Kirby Danford and Asa Langrell on July 25, 2001.

FILED December 7, 2001
BAKER COUNTY SURVEYOR
SURVEY NO. 8-42-11
CORNER PRES. NO. ~~CP #68~~

CP# 69

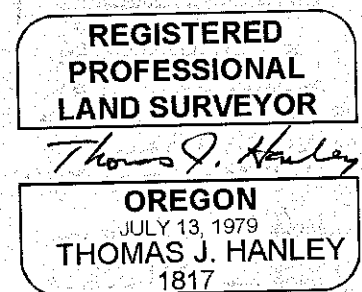

Renews June 30, 2003