


CERTIFIED RECORD OF LAND CORNER MONUMENTATION

History of original corner establishment:

Corner established by W. B. Barr under contract dated September 10, 1880.

Surveyor's General record states:

Marked a quartz rock 12 ins. x 10 ins. x 6 ins. and dug pits.

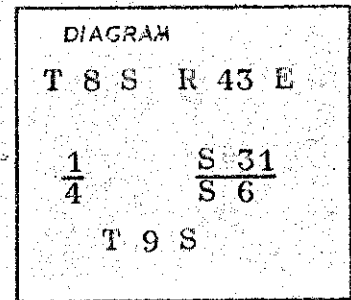

Description of corner evidence found:

Found 12 ins. x 10 ins. x 7 ins. quartz stone in fence junction. Fence bears East, West and South.

Description of monument and accessories established to perpetuate the original location of this corner

Set a 2½ inch brass cap on a 1 inch iron pipe, 30 inches long, 24 inches in the ground, marked thus:

T 8 S R 43 E


$\frac{1}{4}$ $\frac{S 31}{S 6}$

T 9 S

CS 1978

Corner remonumented April 21, 1978.

Office of County Surveyor County of Baker
 State of Oregon, I hereby certify that the within instrument was filed in this office
 for record on the 3 day of May, 1978.
 _____ by _____
 (COUNTY OFFICIAL) (DEPUTY)

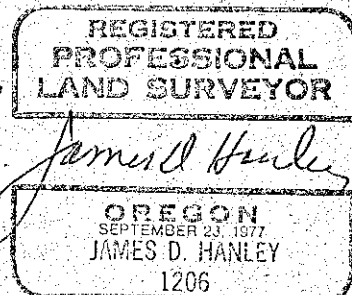

FILED MAY 3, 1978
 BAKER COUNTY SURVEYOR
 SURVEY NO. 8-43-2
9-43-3