


CERTIFIED RECORD OF LAND CORNER MONUMENTATION

History of original corner establishment:

Corner established by W. B. Barr under contract dated September 10, 1880.

Surveyor's General record states:

Marked basalt rock 14 ins. x 8 ins. x 6 ins. for corner to Sections 4, 5, 32, and 33.

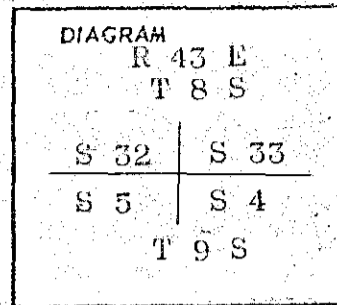


Description of corner evidence found:

None. This corner position occupied by rock crusher and buildings in the past as explained by Walt Love.

Description of monument and accessories I established to perpetuate the original location of this corner

Set a 2½ inch brass cap on a 1 inch iron pipe, 30 inches long, 24 inches in the ground, marked thus:

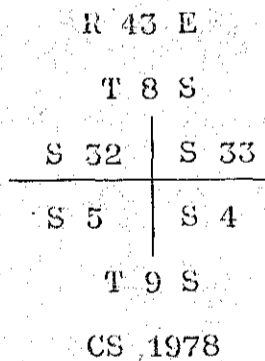

Corner remonumented May 1, 1978.

Office of.....County Surveyor..... County of..... Baker  
 State of..... Oregon....., I hereby certify that the within instrument was filed in this office  
 for record on the .....3... day of..... May, 1978.  
 ..... by .....  
(COUNTY OFFICIAL) (DEPUTY)

FILED May 3, 1978  
 BAKER COUNTY SURVEYOR  
 SURVEY NO. 8-43-3

REGISTERED  
 PROFESSIONAL  
 LAND SURVEYOR

*James D. Hanley*  
 OREGON  
 SEPTEMBER 23, 1977  
 JAMES D. HANLEY  
 1206  
PRO-798-33