


CERTIFIED RECORD OF LAND CORNER MONUMENTATION

History of original corner establishment:

Corner established by W. B. Barr under contract dated September 10, 1880.

Surveyor's General record states:

Marked basalt rock 16 ins. x 14 ins. x 8 ins. for corner to Sections 28, 29, 32, and 33, and raised mound alongside.

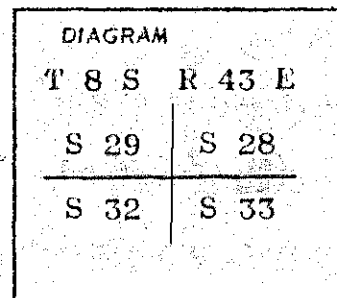


Description of corner evidence found:

Found 14 ins. x 8 ins. x 6 ins. quartz stone in rock mound.

Description of monument and accessories established to perpetuate the original location of this corner

Set a 2½ inch brass cap on a 1 inch iron pipe, 30 inches long, 24 inches in the ground, and buried stone 5 ft South.

Monument marked thus:

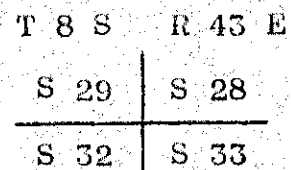

CS 1978

Corner remonumented April 19, 1978.