


CERTIFIED RECORD OF LAND CORNER MONUMENTATION

History of original corner establishment:

Corner established by W. B. Barr under contract dated September 10, 1880.

Surveyor's General record states:

Marked quartz rock 12 ins. x 8 ins. x 6 ins. and raised mound alongside.

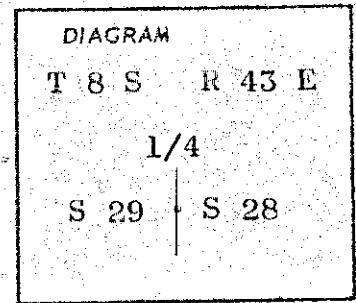


Description of corner evidence found:

Found 10 ins. x 6 ins. x 5 ins. quartz rock in mound.

Description of monument and accessories established to perpetuate the original location of this corner

Set a 2½ inch brass cap on a 1 inch iron pipe, 30 inches long, 24 inches in the ground, and buried stone 5 ft. North and set wood post 4 ft. West.

Monument marked thus: T 8 S R 43 E

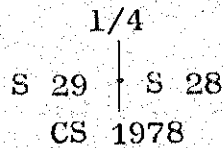

Corner remonumented April 19, 1978.

Office of Baker County Surveyor, County of Baker
State of Oregon, I hereby certify that the within instrument was filed in this office
for record on the 3 day of May, 1978.

(COUNTY OFFICIAL)

by

(DEPUTY)

FILED May 3, 1978

BAKER COUNTY SURVEYOR

SURVEY NO. 8-43-5

REGISTERED PROFESSIONAL LAND SURVEYOR
<i>James D. Hanley</i>
OREGON SEPTEMBER 23, 1977 JAMES D. HANLEY 1206