


CERTIFIED RECORD OF LAND CORNER MONUMENTATION

History of original corner establishment:

Corner established by W. B. Darr under contract dated September 10, 1880.

Surveyor's General record states:

Marked quartz rock 12 ins. x 10 ins. x 10 ins. and raised mound alongside.

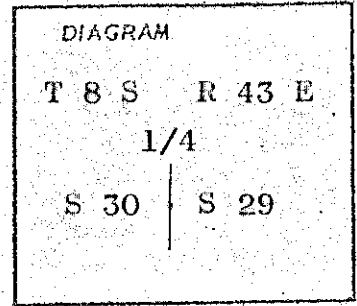


Description of corner evidence found:

Found 11 ins. x 11 inx. x 9 inx. basalt stone.

Description of monument and accessories established to perpetuate the original location of this corner

Set a 2½ inch brass cap on a 1 inch iron pipe, 30 inches long, 24 inches in the ground, and buried stone 5 ft. South. Set steel fence post 2 ft. North.

Monument marked:

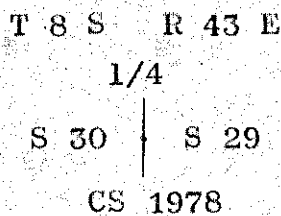

Corner remonumented April 19, 1978.

Office of.....County...Surveyor..... County of.....Baker.....
State of.....Oregon....., I hereby certify that the within instrument was filed in this office
for record on the3 day of.....May, 1978.....

(COUNTY OFFICIAL)

(DEPUTY)

REGISTERED
PROFESSIONAL
LAND SURVEYOR

James D. Hanley
OREGON
SEPTEMBER 23, 1977
JAMES D. HANLEY
1206

FILED May 3, 1978
BAKER COUNTY SURVEYOR
SURVEY NO. 8-43-9